

NOV 01 1999

SECTION

LAND CORNER RECORDATION CERTIFICATE
Filing Requirement of Act 74, Mich. P.A. 1970

For corners in
Osceola

(County)

Located In:

Corner Code #

- | | | | |
|------------------------------------|-----|----|-----|
| 1. Public Land Survey | 17N | 9W | M-8 |
| | T | R | |
| | T | R | |
| | T | R | |
| | T | R | |
| 2. Property Controlling in Section | S | T | R |
| | S | T | R |
| 3. Miscellaneous Property in Sec. | S | T | R |
| | S | T | R |

Register of Deeds Stamp & File Number

4. Lot No. _____, Recorded Plat _____
5. Private Claims _____

I, Robert L. Wetherell, in a field survey on Aug 10, 1999 do hereby state that under requirements of P.A. 74, Michigan P.A. of 1970, the corner points mentioned in lines 1 and 2 above were in conformance with regulations and rules therefore as required in the current manual of survey instructions of the United States Department of the Interior, Bureau of Land Management or by a decree of a Court of Law and /or that the corner points mentioned in lines 3, 4 and 5 above were in conformance with the rules of the Michigan Board of Land Surveyors or by a Decree of a Court of Law, established, re-established, monumented, recovered, found as expressed below:

NOTE: Not more than 2 corners, all in the same town and range, may be recorded on this certificate.

M-8 - E 1/4 Corner of Section 24, T17N, R9W

A. Description of original monument and accessories and/or subsequent restoration:

1838 - J. Hodgson
Cor is 14" Birch

1891 - 1904 - A. Temple/F. Trumbull
Remonumentation of T17N, R9W
Set 3" Clay tiles
"Identified by found Birch tree"
#1- Big Stone (4') S56 1/2 50 Lk.

(SEE OVER FOR CONTINUATION OF "A")

B. Description of corner evidence found and/or method applied in restoring or reestablishing corner:

I found McClung's Osceola County Monument and 3/4" rod in tile.

Condition of the accessories are as follows: #1 Found in good condition, #2 Found in good condition, #3 Found stump, #4 Found in poor condition, #5 Found in good condition, #6 Found in good condition and #7 Found in good condition.

C. Description of monument for corner and accessories established to perpetuate locating the position of the corner:

I accepted Osceola County Monument (1 1/2" pipe Osceola County Remon Cap) and 3/4" rod in tile as a substantial marker for the corner and is accepted it as a careful and faithful perpetuation of the position of the original corner.

- 12" Dbl. Maple (Nail in S. Side) East 52.95' #7
- 14" Dbl. Maple (Nail in N. side) S50E 30.1' #2
- 4" Dbl. Maple (Nail in W. side) S15W 23.34' #5
- 10" Dbl. Maple (Nail in S. side) N70W 30.43' #6
- 4' Big Stone (highest pt. on rock) S50W 32.6' #1


Signed by Robert L. Wetherell Date 8-26-99

Surveyor's Michigan License No. 24624

APPROVED LAND CORNER
P.A. 345 OF 1990
Osceola County

8-26-99

R. L. W.

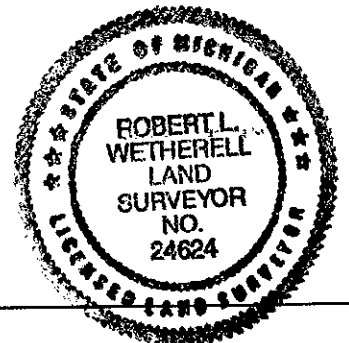

CONTINUATION OF DESCRIPTION OF ORIGINAL MONUMENT AND ACCESSORIES AND/OR SUBSEQUENT RETORATION.

1978- Gray LS 17741

Survey Records

L. 360 Page 276

Fd. 3/4" Iron Rod

#2 - 18" Twin Maple S67E 29.92'

#3 - 24" Twin Willow West 34.20'

#4 - Fence Cor. North 5.66'

1998- McClung LS 13037

Survey Record

L 650, pg. 528

Fd. Iron in Tile

Set Osceola Co. Monument

#2 - 14" Dbl. Maple (w. Nail) S50E 30.01'

#4 - Rotted Fence Post (w nail) North 5.7'

#5 - 4" Dbl. Maple S15W 23.3'

#6 - 10" Dbl. Maple N70W 30.6'

#7 - 12" Dbl. Maple East 53.30'

OSCEOLA COUNTY
REGISTER OF DEEDS

99 SEP -3 AM 11:48

Manojo Campbell

SURVEY &
REMONUMENTATION

NOV 01 1999

SECTION