

**SURVEY &  
REMONUMENTATION**

**FEB 12 1998**

**SECTION**

**LAND CORNER RECORDATION CERTIFICATE  
Filing Requirement of Act 74, Mich. P.A. 1970**

For corners in

Osceola

(County)

Located In:

Corner Code #

- |                                       |      |                 |            |
|---------------------------------------|------|-----------------|------------|
| 1. Public Land Survey                 |      | <u>T7N R10W</u> | <u>A-8</u> |
|                                       |      | T___ R___       | _____      |
|                                       |      | T___ R___       | _____      |
|                                       |      | T___ R___       | _____      |
| 2. Property Controlling<br>in Section | S___ | T___ R___       | _____      |
|                                       | S___ | T___ R___       | _____      |
| 3. Miscellaneous<br>Property in Sec.  | S___ | T___ R___       | _____      |
|                                       | S___ | T___ R___       | _____      |

APPROVED LAND CORNER  
P.A. 345 OF 1990  
Osceola County

*18 Sept 1997*  
*Matthew McClung*

Register of Deeds Stamp & File Number

4. Lot No. \_\_\_\_\_, Recorded Plat \_\_\_\_\_  
5. Private Claims \_\_\_\_\_

I, Matthew McClung, in a field survey on July 15, 1997 do hereby state that under requirements of P.A. 74, Michigan P.A. of 1970, the corner points mentioned in lines 1 and 2 above were in conformance with regulations and rules therefore as required in the current manual of survey instructions of the United States Department of the Interior, Bureau of Land Management or by a decree of a Court of Law and /or that the corner points mentioned in lines 3, 4 and 5 above were in conformance with the rules of the Michigan Board of Land Surveyors or by a Decree of a Court of Law, established, re-established, monumented, recovered, found as expressed below:

NOTE: Not more than 2 corners, all in the same town and range, may be recorded on this certificate.

1	A	B	C	D	E	F	G	H	I	J	K	L	M
2		6		5		4		3		2		1	
3													
4		7		8		9		10		11		12	
5													
6		18		17		16		15		14		13	
7													
8		19		20		21		22		23		24	
9													
10		30		29		28		27		26		25	
11													
12		31		32		33		34		35		36	
13													

**A. Description of original monument and accessories and/or subsequent restoration:**

The original corner was set by deputy surveyor John Hodgson on 4 Nov. 1837. Set wood post at 40.00 chains from South.  
Beech 10" S31W 11 lks.  
Hemlock 10" N32W 16 lks.

From 1891 to 1904 approximately, Osceola County had a remonumentation program, in which surveyors Temple and Trumbull, did the work. For the most part, a 3" glazed tile filled with cinders from a forge, were placed at each government set corner in the township. There were supposed to be 3 tile per corner, placed atop of each other, (continued on back)

**B. Description of corner evidence found and/or method applied in restoring or reestablishing corner:**


Found 1" X 1/8" strap iron 13" long leaning 45 degrees to South. Excavated to 12" and found 1 Piece crock Approximate 1 1/2" X 2" long Drove 5/8" iron bar at base of iron. Placed Osceola County Monument over rod 6" below road surface. Corner is in East & West fence row and center line of North and South road. Distance to North matched Wetherell survey at 2,613.68 feet.

**C. Description of monument for corner and accessories established to perpetuate locating the position of the corner:**

Corner A-8. Osceola County Monument, which is a 3" brass cap mounted on a 1" pipe 18" in length.  
Ash 8" (Wetherell calls for Box Elder) N16E 131.40 feet. O.B.T.  
Elm 4" S38E 61.72 feet.  
Power Pole N82E 39.74 feet.  
Highest Point of 4' x 4' Rock N76E 31.78 feet.  
4" Cherry S44E 40.99 feet. O.B.T.

Signed by Matthew McClung  
Surveyor's Michigan License No. 13037

Date July 15, 1997

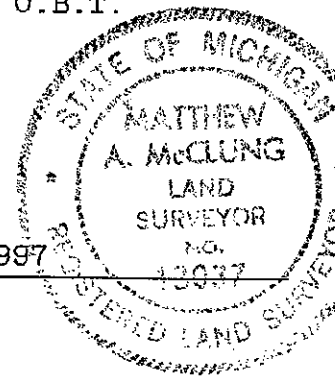

OSCEOLA COUNTY  
REGISTER OF DEEDS

97 NOV 26 AM 11:47

*Nancy Crawford*

thereby making the corner 4 feet long. Sometimes a solid tile, with a cross in the top was used, and sometimes a 1/2" iron bars were added to the tile. Notes of the work were kept in ledgers, and given to the townships, and 5 of the townships have been entered in the County Survey records.

Act 132  
Lake County Liber 003, Page 136  
Dated July 27, 1988 by Wetherell  
4" Cherry S44E 40.99 feet  
6" Box Elder N16E 131.20 feet

SURVEY &  
REMONUMENTATION

FEB 12 1998

SECTION