

FEB 15 1998

SECTION

LAND CORNER RECORDATION CERTIFICATE
Filing Requirement of Act 74, Mich. P.A. 1970

For corners in

Osceola
(County)

Located in:

Corner Code #

- | | | |
|------------------------------------|----------------------------|------------|
| 1. Public Land Survey | T <u>17</u> N <u>R10</u> W | <u>D-7</u> |
| | T ___ R ___ | _____ |
| | T ___ R ___ | _____ |
| | T ___ R ___ | _____ |
| 2. Property Controlling in Section | S ___ T ___ R ___ | _____ |
| | S ___ T ___ R ___ | _____ |
| 3. Miscellaneous Property in Sec. | S ___ T ___ R ___ | _____ |
| | S ___ T ___ R ___ | _____ |

APPROVED LAND CORNER
P.A. 345 OF 1990
Osceola County
Matthew McClung
12 Nov 1998
Register of Deeds Stamp & File Number

4. Lot No. _____, Recorded Plat _____
5. Private Claims _____

I, Matthew McClung in a field survey on 9-12, 1998 do hereby state that under requirements of P.A. 74, Michigan P.A. of 1970, the corner points mentioned in lines 1 and 2 above were in conformance with regulations and rules therefore as required in the current manual of survey instructions of the United States Department of the Interior, Bureau of Land Management or by a decree of a Court of Law and /or that the corner points mentioned in lines 3, 4 and 5 above were in conformance with the rules of the Michigan Board of Land Surveyors or by a Decree of a Court of Law, established, re-established, monumented, recovered, found as expressed below:

NOTE: Not more than 2 corners, all in the same town and range, may be recorded on this certificate.

| | A | B | C | D | E | F | G | H | I | J | K | L | M |
|----|----|---|----|---|----|---|----|---|----|---|----|---|---|
| 1 | | | | | | | | | | | | | |
| 2 | 6 | | 5 | | 4 | | 3 | | 2 | | 1 | | |
| 3 | | | | | | | | | | | | | |
| 4 | 7 | | 8 | | 9 | | 10 | | 11 | | 12 | | |
| 5 | | | | | | | | | | | | | |
| 6 | 18 | | 17 | | 16 | | 15 | | 14 | | 13 | | |
| 7 | | | | | | | | | | | | | |
| 8 | 19 | | 20 | | 21 | | 22 | | 23 | | 24 | | |
| 9 | | | | | | | | | | | | | |
| 10 | 30 | | 29 | | 28 | | 27 | | 26 | | 25 | | |
| 11 | | | | | | | | | | | | | |
| 12 | 31 | | 32 | | 33 | | 34 | | 35 | | 36 | | |
| 13 | | | | | | | | | | | | | |


A. Description of original monument and accessories and/or subsequent restoration:

The original corner was set by deputy surveyor John Hodgson on 10 June 1838. Set wood post 39.90 chains from East.
Elm 30" N29E 11 lks.
Sugar 10" S18W 6 lks.

From 1891 to 1904 approximately, Osceola County had a remonumentation program, in which surveyors Temple and Trumbull, did the work. For the most part, a 3" glazed tile filled with cinders from a forge, were placed at each government set corner in the township. There were supposed to be 3 tile per corner, placed atop of each other, (continued on back)

B. Description of corner evidence found and/or method applied in restoring or reestablishing corner:

Found Monument box 0.5' South of road centerline of East and West road.
Found 1/2" rod in monument box.

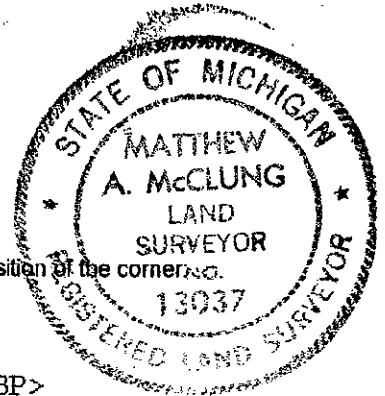

C. Description of monument for corner and accessories established to perpetuate locating the position of the corner:

Corner D-7. 1/2" rod in monument box.

- Iron corner fence post S20E 62.55 feet. OBP>
- Iron corner fence post N40W 85.3 feet. OBP.
- SW corner of School House North 67.85 feet. OBP>
- SE corner of School House N15E 72.8 feet. OBP.

Signed by Matthew McClung
Surveyor's Michigan License No. 13037

Date 1 Dec 1998

SURVEY &
REMONUMENTATION

FEB 16 1999

SECTION

OSCEOLA COUNTY
REGISTER OF DEEDS

98 DEC -1 PM 4: 57

Nancy Crawford

thereby making the corner 4 feet long. Sometimes a solid tile, with a cross in the top was used, and sometimes a 1/2" iron bars were added to the tile. Notes of the work were kept in ledgers, and given to the townships, and 5 of the townships have been recorded in the County Surveyor's records.

| | |
|-------------------------------------|-------------------------------------|
| P.A. 74, Liber 2; page 41 by Hooth. | Act 132, Liber 360, page 274 & 275, |
| 1/2" steel rod in mon. box. in | by Wood Found 1/2" rod in mon. box. |
| fence lines N & S. | 35.63' North 2" Maple. |
| Corner fence post N. 33' | 34.15' N15W 4" Basswood |
| Corner fence post S. 33' | 90.76' N70W Fence post. |
| Beech 31" South 48.06' | |
| Tele. pole N55W 54.14' | |
| SW Corner School N05E 68.02' | |
| SE Corner School N25E 73.04' | |

P.A. 132, Liber 571, pages 680,
681 & 682, by Wetherell.
10" Maple North 106.72'
Iron fence corner post S20W 62.55'
Iron fence corner post N37W 85.33'