

FEB 16 1999

SECTION

LAND CORNER RECORDATION CERTIFICATE
Filing Requirement of Act 74, Mich. P.A. 1970

For corners in

| | | |
|------------------------------------|-------------------|---------------|
| <u>Osceola</u> (County) | Located In: | Corner Code # |
| 1. Public Land Survey | <u>T17N R10W</u> | <u>G-7</u> |
| | T ___ R ___ | ___ |
| | T ___ R ___ | ___ |
| | T ___ R ___ | ___ |
| 2. Property Controlling in Section | S ___ T ___ R ___ | ___ |
| | S ___ T ___ R ___ | ___ |
| 3. Miscellaneous Property in Sec. | S ___ T ___ R ___ | ___ |
| | S ___ T ___ R ___ | ___ |

APPROVED LAND CORNER
P.A. 345 OF 1990
Osceola County

Matthew McClung
12 Nov 1998

Register of Deeds Stamp & File Number

4. Lot No. _____, Recorded Plat _____
5. Private Claims _____

I, Matthew McClung, in a field survey on 11-2, 1998 do hereby state that under requirements of P.A. 74, Michigan P.A. of 1970, the corner points mentioned in lines 1 and 2 above were in conformance with regulations and rules therefore as required in the current manual of survey instructions of the United States Department of the Interior, Bureau of Land Management or by a decree of a Court of Law and /or that the corner points mentioned in lines 3, 4 and 5 above were in conformance with the rules of the Michigan Board of Land Surveyors or by a Decree of a Court of Law; established, re-established, monumented, recovered, found as expressed below:

NOTE: Not more than 2 corners, all in the same town and range, may be recorded on this certificate.

| | | | | | | | | | | | | |
|----|----|----|----|----|----|----|---|---|---|---|---|---|
| A | B | C | D | E | F | G | H | I | J | K | L | M |
| 1 | | | | | | | | | | | | |
| 2 | 6 | 5 | 4 | 3 | 2 | 1 | | | | | | |
| 3 | | | | | | | | | | | | |
| 4 | 7 | 8 | 9 | 10 | 11 | 12 | | | | | | |
| 5 | | | | | | | | | | | | |
| 6 | 18 | 17 | 16 | 15 | 14 | 13 | | | | | | |
| 7 | | | | | | | | | | | | |
| 8 | 19 | 20 | 21 | 22 | 23 | 24 | | | | | | |
| 9 | | | | | | | | | | | | |
| 10 | 30 | 29 | 28 | 27 | 26 | 25 | | | | | | |
| 11 | | | | | | | | | | | | |
| 12 | 31 | 32 | 33 | 34 | 35 | 36 | | | | | | |
| 13 | | | | | | | | | | | | |

A. Description of original monument and accessories and/or subsequent restoration:

The original corner was set by deputy surveyor John Hodgson on 10 June 1838. Set wood post 80.00 chains from South.
Sugar 16" S80E 19 lks.
Sugar 16" N52W 35 lks.


From 1891 to 1904 approximately, Osceola County had a remonumentation program, in which surveyors Temple and Trumbull, did the work. For the most part, a 3" glazed tile filled with cinders from a forge, were placed at each government set corner in the township. There were supposed to be 3 tile per corner, placed atop of each other, (continued on back)

B. Description of corner evidence found and/or method applied in restoring or reestablishing corner:

Excavated to 1" below surface of asphalt and found top of square head screw. Excavated to 6", removed screw 5" long, and found no other evidence of corner with magnetic locator. Excavated to 20" and found no other evidence of corner. Placed Osceola County Monument in position of screw, 1" below surface. Corner is in centerline of N & S road and 3' South of E & W road.

C. Description of monument for corner and accessories established to perpetuate locating the position of the corner:

Corner G-7. Osceola County Monument, which is a 3" brass cap mounted on a 1" pipe 18" in length.
Power pole N42W 47.35 feet. O.B.P.
30" Walnut S58E 64.9 feet. O.B.P.
NE Corner Pole Building S66W 66.55 feet. O.B.P.
6" Blue Spruce N52E 52.7 feet. O.B.P.

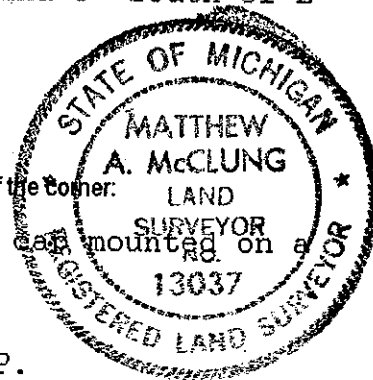

Signed by *Matthew McClung*
Surveyor's Michigan License No. 13037

Date 1 Dec 1998

FEB 18 1999

SECTION

OSCEOLA COUNTY
REGISTER OF DEEDS

98 DEC -1 PM 4:58

Nancy Crawford

thereby making the corner 4 feet long. Sometimes a solid tile, with a cross in the top was used, and sometimes a 1/2" iron bars were added to the tile. Notes of the work were kept in ledgers, and given to the townships, and 1 of the townships have been recorded in the County Survey records.

Richmond Twp. Book, pages 20 & 21 Act 132, Liber 327, page 178, Fletcher.
Iron. Dated 1909. Power pole N45W 47.32'
Elm NW 59.0' - 16" Walnut SE 64.2' 24" Maple S65E 64.99'

PA 132, Liber 474, page 344. Act 132, Liber 529, page 456. Wetherell
Power pole N38W 47.35' P. pole N38W 47.35'
30" Ash S56E 64.95' 30" Walnut S56E 64.95
12" Apple N46E 63.05' 10" Apple N46E 63.05'

Act 132, Liber 504, Page 132 Act 132, Liber 599, page 338. Wetherell
No description or witnesses. P. Pole N38W 47.35'
Power pole N73W 162.82' 30" Ash N56E 64.95'
NE Cor. Pole Building S68W 66.55'
4" Spruce N55E 53.0'

Act 132, Liber 629, page 768
P. Pole N38W 47.35'
NE Cor. Building S68W 66.55'
30" Ash S56E 64.95'
4" B. Spruce N55E 53.0'