

**SURVEY & REMONUMENTATION**


DEC 13 2000

**LAND CORNER RECORDATION CERTIFICATE**

FILING REQUIREMENT OF ACT 74, Mich. P.A. 1970

SECTION

For corners in <u>Osceola</u>	Located in:	Corner Code#
1. Public Land Survey	T <u>17 N</u>	R <u>10 W</u> H-13
	T	R
	T	R
	T	R
2. Property Controlling S in Section	T	R
	S	T
3. Miscellaneous S Property in Sec.	T	R
	S	T
4. Lot No. _____ Recorded Plat _____		
5. Private Claims _____		

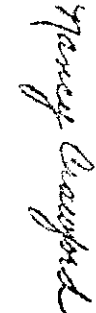  
**OSCEOLA COUNTY**  
**REGISTER OF DEEDS**  
**00 NOV -2 PM 4: 11**  
 Register of Deeds Stamp & File Number

	A	B	C	D	E	F	G	H	I	J	K	L	M
1													
2	6	5	4	3	2	1							
3													
4	7	8	9	10	11	12							
5													
6	18	17	16	15	14	13							
7													
8	19	20	21	22	23	24							
9													
10	30	29	28	27	26	25							
11													
12	31	32	33	34	35	36							
13													

I, Robert L. Wetherell, in a field survey on September 18, 2000, do hereby certify that under requirements of P.A. 74, Michigan P.A. of 1970, the corner points mentioned in lines 1 and 2 above were in conformance with regulations and rules therefore as required in the current manual of survey instructions of the United States Department of the Interior, Bureau of Land Management or by decree of a Court of Law and/or that the corner points mentioned in lines 3, 4, and 5 above were in conformance with the rules of the Michigan Board of Land Surveyors or by a Decree of a Court of Law; established, re-established, monumented, re-monumented, recovered, found as expressed below:

**H-13 - S. 1/4 corner Section 34, T17N, R10W.**

**A. Description of original monument and accessories and/or subsequent restoration:**

**1837 - J. Hodgson, G.L.O.**  
 #1 - 8" Ironwood N66°E, 25 Links  
 #2 - 7" Sugar N84°W 17 Links

No subsequent restoration on record.

**B. Description of corner evidence found and/or method applied in restoring of reestablishing corner:**

I found a 1/2" rod in a monument box in the center of an East and West blacktop road. I found another 1/2" rod in a monument box 4.8 feet West, which is recorded as the N. 1/4 corner Sec. 3, T16N, R10W, in Liber 02, Pg. 407, Mecosta Co., Mi., by Jerry Taylor, LS 32342. I accepted the Easterly 1/2" rod and from it I measured 2634.6 feet East to the Section corner of Section 34 and 2632.8 feet West to the S.W. corner of Section 34.


Condition of the accessories are as follows: #1 Gone, 2 Gone.

**C. Description of monument for corner and accessories established to perpetuate locating the position of the corner:**

I replaced the 1/2" iron rod with a 1" x 18" Iron Rod with a 1" x 18" Iron Pipe with Osceola Co. Remon Cap, and is accepted as a careful and faithful reestablishment of the position of the original corner.

Iron and Cap - West 4.80'  
 P. Pole N67°W 107.60' (P.K. Nail N.E. side)  
 P. Pole N65°E 67.76' (P.K. Nail in N.W. side)  
 15" Walnut S52°W 46.7' (center of tree)  
 17" Walnut 2°W 31.3' (center of tree)  
 19" Walnut S49°E 57.5' (center of tree)

APPROVED LAND CORNER  
 P.A. 245 OF 1990  
 Osceola County  
R.L.W.  
10-31-2000

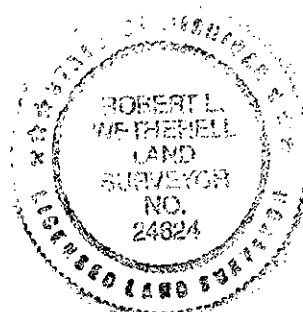

Signed by Robert L. Wetherell Date November 1, 2000

Surveyor's Michigan License No. 24624

FORM APPROVED BY MICHIGAN STATE BOARD OF LAND SURVEYORS, JAN. 28, 1971  
 REVISED MAY 14, 1975  
 REVISED JAN. 1993  
 ADAPTED FOR WORD PROCESSING JANUARY, 1999