

**SURVEY & REMONUMENTATION**


DEC 13 2000

**LAND CORNER RECORDATION CERTIFICATE**

FILING REQUIREMENT OF ACT 74, Mich. P.A. 1970

SECTION

For corners in <u>Osceola</u>	Located in:	Corner Code#
1. Public Land Survey	T 17 N R 10 W	I-13
	T R	
	T R	
	T R	
2. Property Controlling S in Section	T R	
	S T R	
3. Miscellaneous S Property in Sec.	T R	
	S T R	
4. Lot No. _____ Recorded Plat _____		
5. Private Claims _____		

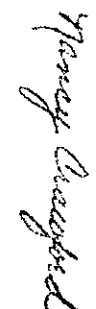  
**OSCEOLA COUNTY**  
**REGISTER OF DEEDS**  
**00 NOV -2 PM 4: 11**  
 Register of Deeds Stamp & File Number

	A	B	C	D	E	F	G	H	I	J	K	L	M
1													
2	6	5	4	3	2	1							
3													
4	7	8	9	10	11	12							
5													
6	18	17	16	15	14	13							
7													
8	19	20	21	22	23	24							
9													
10	30	29	28	27	26	25							
11													
12	31	32	33	34	35	36							
13													

I, Robert L. Wetherell, in a field survey on September 18, 2000, do hereby certify that under requirements of P.A. 74, Michigan P.A. of 1970, the corner points mentioned in lines 1 and 2 above were in conformance with regulations and rules therefore as required in the current manual of survey instructions of the United States Department of the Interior, Bureau of Land Management or by decree of a Court of Law and/or that the corner points mentioned in lines 3, 4, and 5 above were in conformance with the rules of the Michigan Board of Land Surveyors or by a Decree of a Court of Law; established, re-established, monumented, re-monumented, recovered, found as expressed below:

I-13 - Section corner common to Sections 34 & 35, T17N, R10W, - South Sec. line.

**A. Description of original monument and accessories and/or subsequent restoration:**

- |                                       |   |
|---------------------------------------|---|
| <u>1837 - J. Hodgson, G.L.O.</u>      | <u>1983 - J. Pierson, LS 19305</u>                    |
| #1 - 20" Sugar N41°E 33 Links         | Shows distance of 2633 feet to the S. ¼ cor. Sec. 35. |
| #2 - 20" Sugar N58°W 23 Links         | No accessories given.                                 |
| Corner of Sections 2 & 3, T16N, R10W, |   |
| is 19 Links West.                     |   |

**B. Description of corner evidence found and/or method applied in restoring of reestablishing corner:**

I found a ½" Capped Iron (unreadable) over top of an old ½" rod in a monument box 3 feet more or less North of the painted centerline of an East and West blacktop road. I found the corner common to Sections 2 and 3 of Town 16 North, Range 10 West, 12.45 feet West. I measured 2633 feet East to the South ¼ corner of Section 35 and 2634.6 feet West to the South ¼ corner Section 34.


Condition of the accessories are as follows: #1 Gone, #2 Gone.

**C. Description of monument for corner and accessories established to perpetuate locating the position of the corner:**

I replaced the ½" capped iron with a 1" x 18" Iron Pipe with Osceola County Remon Cap, and is accepted as a careful and faithful reestablishment of the position of the original corner.

- 8" Maple S17°W 137.76' (60d spike E. side)
- 6" Elm S76°W 94.71' (60d spike S. side)
- P. Pole N78°W 188.91' (60d spike S. side)
- P. Pole N85°E 211.71' (60d spike S. side)
- Mecosta Co. Capped Monument - West 12.45'

APPROVED LAND CORNER  
 P.A. 345 OF 1990  
 Osceola County  
R. L. W.  
10-31-2000

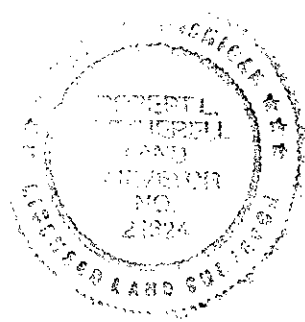

Signed by Robert L. Wetherell  
 Surveyor's Michigan License No. 24624

Date November 1, 2000

FORM APPROVED BY MICHIGAN STATE BOARD OF LAND SURVEYORS, JAN.28, 1971  
 REVISED MAY 14, 1975  
 REVISED JAN. 1983  
 ADAPTED FOR WORD PROCESSING JANUARY, 1999