LAND CORNER RECORDATION CERTIFICATE

Filing Requirement of Act 74, Mich. P.A. 1970

For corners in OSCEOLA (County)

	Located In:	Corner Code ##
1. Public Land Survey	T 18N R 7W	K-1, K-2
	T ___ R ___	L-1
	T ___ R ___	
	T ___ R ___	
2. Property Controlling	S ___ T ___ R ___	
in Section	S ___ T ___ R ___	
3. Miscellaneous	S 2 T ___ R ___	#733.7' N OF K-2
Property in Sec.	S ___ T ___ R ___	

Register of Deeds Stamp & File Number

4. Lot No. _____, Recorded Plat _____
5. Private Claims _____

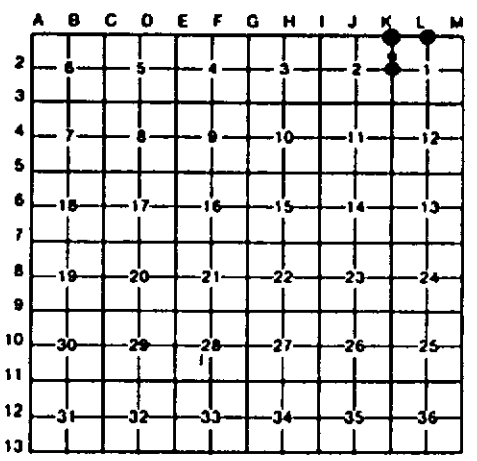

I, CARL F. ROSER, in a field survey on APRIL 13, 19 93, do hereby certify that under requirements of P.A. 74, Michigan P.A. of 1970, the corner points mentioned in lines 1 and 2 above were in conformance with regulations and rules therefore as required in the current manual of survey instructions of the United States Department of the Interior, Bureau of Land Management or by a decree of a Court of Law and/or that the corner points mentioned in lines 3, 4 and 5 above were in conformance with the rules of the Michigan Board of Land Surveyors or by a Decree of a Court of Law; established, re-established, monumented, re-monumented, recovered, found as expressed below:

NOTE: Not more than 4 corners, all in the same town and range, may be recorded on this certificate.

A. Description of original monument and accessories and/or subsequent restoration:

K-1 K-2 L-1 #

(NO EVIDENCE OF G.L.O. CORNER, B.T'S, LINE TREES & TOPOGRAPHY, AS CALLED OUT IN THE G.L.O. LINE NOTES; UNLESS NOTED IN ITEM "B" BELOW.)

B. Description of corner evidence found and/or method applied in restoring or reestablishing corner:

K-1	K-2	L-1	#
FD ANGLE IRON & TILE FOR NE COR SEC 2 AS CALLED FOR IN M. McCLUNG CERT OF SURVEY, LI.404, PG.74.	FD ANGLE IRON FOR E 1/4 COR SEC 2. IRON FITS P.S., P.LAPHAM CERT OF SURVEY IN SE 1/4 OF SEC 2; LI 295, PG 221 OF 1972. TRAIL RD NW-SE IS 6' NORTH.	ACCEPTED FD REROD & TILE FOR N 1/4 COR SEC 1. COR FALLS IN LOWLAND HARDWOODS & IS PRESENTLY UNDER WATER. EDGE OF BAYOU IS 380'± EAST. WOOD FRAME CABIN IS N65°E, 300'± 40'.	DROVE REROD ON EAST LINE OF SEC 2 AND SOUTH SIDE OF MIDDLE BRANCH RIVER. S'LY EDGE OF RIVER IS 95'± NORTH AND 42'± EAST.

C. Description of monument for corner and accessories established to perpetuate locating the position of the corner:

K-1	K-2	L-1	#
FD 1" x 1" ANGLE IR IN 3" VIT TILE. ADDED CED POST W/LOC TAG	FD 1" x 1" ANGLE IRON. ADDED DNR MON & CED POST.	FD 1/2" REROD W/RLS CAP IN 3" VIT TILE. ADDED CED POST W/LOC TAG.	DROVE 5/8" x 34" REROD W/RLS CAP. SET CED POST W/LOC TAG.
#23" W PINE N60°W 9.42'		#23" MAPLE N80°W 21.37'	6" CEDAR N55°W 12.4'
#19" W PINE EAST 12.05'	3" W PINE N25°W 32.0'	5" R OAK N40°W 31.28'	7" SUG MAPLE N05°W 18.7'
6" CEDAR S45°E 6.72'	#12" B OAK N70°E 23.1'	5" MAPLE N25°E 34.78'	18" SWP OAK N35°E 27.2'
8" CEDAR S20°W 27.76'	# 9" MAPLE S45°E 28.4'	#11" & 7"MAPLE S20°W 7.63'	10" CEDAR S75°E 25.5'
FD OLD 16" W PINE STP W/3 FACE NOTCHES S85°W 20.4'	#28" W PINE S40°W 4.9'		
#RLS M. McCLUNG 1983 WIT.	#RLS P.LAPHAM 1972 WIT.	#RLS M. McCLUNG 1983 WIT.	

Signed by Carl F. Roser 4-25-95 Date _____

Surveyor's Michigan License No. 12028

STATE OF MICHIGAN CARL F. ROSER LAND SURVEYOR No. 12028 REGISTERED LAND SURVEYOR

FORM APPROVED BY MICHIGAN STATE BOARD OF LAND SURVEYORS, JAN. 28, 1971
REVISED MAY 14, 1975
REVISED JAN., 1983