LAND CORNER RECORDATION CERTIFICATE

Filing Requirement of Act 74, Mich. P.A. 1970

For corners in OSCEOLA (County)

	Located In:	Corner Code ##
1. Public Land Survey	T 18N R 7W	K-3
	T ___ R ___	
	T ___ R ___	
	T ___ R ___	
2. Property Controlling	S 12 T ___ R ___	2
in Section	S ___ T ___ R ___	
3. Miscellaneous	S 1 T ___ R ___	1183' E OF
Property in Sec.	S ___ T ___ R ___	CODE 10.

Register of Deeds Stamp & File Number

4. Lot No. _____, Recorded Plat _____
5. Private Claims _____

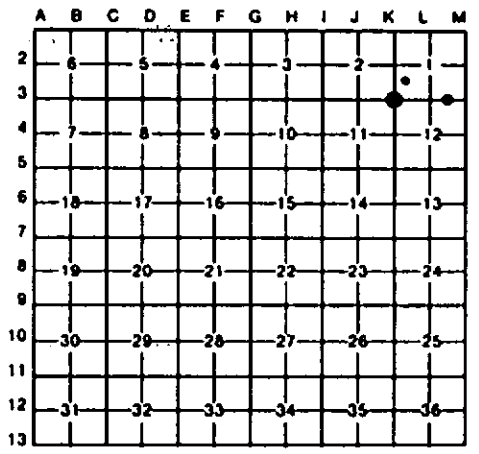

I, CARL F. ROSER, in a field survey on APRIL 13, 19 93, do hereby certify that under requirements of P.A. 74, Michigan P.A. of 1970, the corner points mentioned in lines 1 and 2 above were in conformance with regulations and rules therefore as required in the current manual of survey instructions of the United States Department of the Interior, Bureau of Land Management or by a decree of a Court of Law and/or that the corner points mentioned in lines 3, 4 and 5 above were in conformance with the rules of the Michigan Board of Land Surveyors or by a Decree of a Court of Law; established, re-established, monumented, re-monumented, recovered, found as expressed below:

NOTE: Not more than 4 corners, all in the same town and range, may be recorded on this certificate.

A. Description of original monument and accessories and/or subsequent restoration:

K-3

(NO EVIDENCE OF G.L.O. CORNER, B.T'S, LINE TREES & TOPOGRAPHY, AS CALLED OUT IN THE G.L.O. LINE NOTES; UNLESS NOTED IN ITEM "B" BELOW.)

B. Description of corner evidence found and/or method applied in restoring or reestablishing corner:

K-3	2	1
ACCEPTED FD 1 1/4" PIPE FOR SW COR SEC 1. PIPE WAS USED BY P.S., P.LAPHAM IN 1970 SURVEY IN SE 1/4 S-2 & RECORDED BY P.LAPHAM IN 1980. N'LY EDGE OF MUSKEGON RIVER IS 128'± S.	ESTABLISHED NE COR OF W 1/2 OF NE 1/4 OF S-12 PER STANDARD BLM INSTRUCTIONS.	DROVE REROD ON N LINE OF GOVT LOT 10 OF SEC. 1 (S88 21' 31" E, 1183.20' FROM CORNER CODE 10) AND AT WEST SIDE MUSKEGON RIVER. WEST EDGE OF RIVER IS 148'± EAST.

C. Description of monument for corner and accessories established to perpetuate locating the position of the corner:

K-3			2			1		
FD 1 1/4" PIPE. ADDED CED POST W/LOC TAG.			DROVE 5/8" X 34" REROD W/RLS CAP. SET CED POST W/LOC TAG.			DROVE 5/8" X 34" REROD W/RLS CAP. SET CED POST W/LOC TAG.		
5" W PINE	N25°W	22.1'	4" W PINE	WEST	19.8'	4" W PINE	N20°E	13.9'
1 6" W OAK	N70°E	7.85'	4" W PINE	N50°E	45.1'	6" W PINE	N35°E	25.4'
9" SUG MAPLE	S60°E	28.7'	22" W PINE	S70°E	21.8'	4" BALSAM	S15°E	13.5'
1 9" W BIRCH	S35°W	27.92'	2" BALSAM	S50°W	13.0'	5" W PINE	S55°W	14.3'

1RLS P. LAPHAM WIT.

STATE OF MICHIGAN — CARL F. ROSER — LAND SURVEYOR — No. 12028 — REGISTERED LAND SURVEYOR

Signed by Carl F. Roser Date 4-25-95

Surveyor's Michigan License No. 12028

FORM APPROVED BY MICHIGAN STATE BOARD OF LAND SURVEYORS, JAN. 28, 1971
REVISED MAY 14, 1975
REVISED JAN., 1983