LAND CORNER RECORDATION CERTIFICATE

Filing Requirement of Act 74, Mich. P.A. 1970

For corners in OSCEOLA (County)

	Located In:	Corner Code ##
1. Public Land Survey	T 18N R 7W	K-5, L-4
	T ____ R ____	L-5
	T ____ R ____	
	T ____ R ____	
2. Property Controlling	S 12 T ____ R ____	9
in Section	S ____ T ____ R ____	
3. Miscellaneous	S ____ T ____ R ____	
Property in Sec.	S ____ T ____ R ____	

Register of Deeds Stamp & File Number

4. Lot No. _____, Recorded Plat _____
5. Private Claims _____

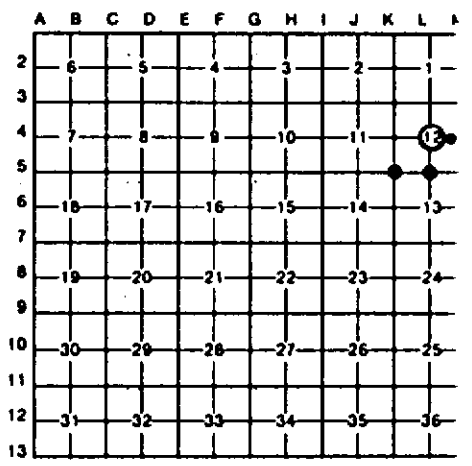

I, CARL F. ROSER, in a field survey on MARCH 24, 19 93, do hereby certify that under requirements of P.A. 74, Michigan P.A. of 1970, the corner points mentioned in lines 1 and 2 above were in conformance with regulations and rules therefore as required in the current manual of survey instructions of the United States Department of the Interior, Bureau of Land Management or by a decree of a Court of Law and/or that the corner points mentioned in lines 3, 4 and 5 above were in conformance with the rules of the Michigan Board of Land Surveyors or by a Decree of a Court of Law; established, re-established, monumented, re-monumented, recovered, found as expressed below:

NOTE: Not more than 4 corners, all in the same town and range, may be recorded on this certificate.

A. Description of original monument and accessories and/or subsequent restoration:

K-5 L-4 L-5 9

(NO EVIDENCE OF G.L.O. CORNER, B.T'S, LINE TREES & TOPOGRAPHY, AS CALLED OUT IN THE G.L.O. LINE NOTES; UNLESS NOTED IN ITEM "B" BELOW.)

B. Description of corner evidence found and/or method applied in restoring or reestablishing corner:

K-5
RECOVERED OLD RUSTED OFF 2" PIPE FOR SW COR S-12 UNDER WATER IN ALDER, WILLOW & ASH SWP. COR FITS RLS M.McCLUNG 1980 WITS. COR IS IN LINE W/FENCE REMAINS N'LY. E-W TRAIL IS 766'± 5' NORTH.

L-4
ESTABLISHED CTR OF S-12 AT INTERSECTION OF 1/4 LINES. CTR OF N-S TRAIL IS 282'± WEST. NW'LY EDGE OF SWAMP IS 162'± 20' EAST.

L-5
FD & ACCEPTED IRON ROD FOR S 1/4 COR S-12 AS RECORDED BY RLS M.McCLUNG IN 1980.

9
ESTABLISHED SE COR OF W 1/2 OF NE 1/4 S-12 PER STANDARD BLM INSTRUCTIONS. S'LY EDGE OF NORWAY CREEK IS 258'± NORTH.

STATE OF MICHIGAN
CARL F. ROSER
LAND SURVEYOR
No. 12028
REGISTERED LAND SURVEYOR

C. Description of monument for corner and accessories established to perpetuate locating the position of the corner:

K-5
FD RUSTED OFF 2" PIPE. DROVE 1" x 96" GALV PIPE W/RLS CAP. SET CED POST.

3" BALSAM	N25°W	43.8'
8" MAPLE	N30°E	28.6'
*10" ASH	N60°E	27.6'
* 8" ASH	S65°W	11.2'

*RLS M. McCLUNG 1984 WIT.

L-4
DROVE 5/8" x 34" REROD W/RLS CAP. SET CED POST W/LOC TAG.

9" MAPL(CLP3)	N35°E	5.1'
18" R PINE	N85°E	20.7'
6" W PINE	S20°E	9.8'
7" R PINE	S80°W	18.0'

L-5
FD 3/4" IRON ROD. ADDED CED POST.

*13" TW R OAK	N75°E	26.25'
*12" HEMLOCK	S05°E	26.75'
*16" MAPLE	S75°W	17.45'
6" MAPLE	N30°W	7.22'

*RLS M. McCLUNG WIT.

9
DROVE 5/8" x 34" REROD W/RLS CAP. SET CED POST W/LOC TAG.

14" BALSAM	N70°W	5.7'
8" MAPLE	N40°W	45.0'
8" ASH	N40°E	11.6'
8" ASH	S80°E	22.3'
FD 1/2" REROD W/ RLS CAP	N88°56'W	47.2'

Signed by Carl F. Roser 4-25-95 Date _____

Surveyor's Michigan License No. 12028

FORM APPROVED BY MICHIGAN STATE BOARD OF LAND SURVEYORS, JAN. 28, 1971
REVISED MAY 14, 1975
REVISED JAN., 1983