

**SURVEY &
REMONUMENTATION**

AUG 27 1996

COMMISSION

LAND CORNER RECORDATION CERTIFICATE
Filing Requirement of Act 74, Mich. P.A. 1970

For corners in
Osceola
(County)

Located In: _____ Corner Code # _____

18N 7W E-4

- | | | | | | | |
|------------------------------------|---|-----|---|-------|---|-------|
| 1. Public Land Survey | T | ___ | R | _____ | | |
| | T | ___ | R | _____ | | |
| | T | ___ | R | _____ | | |
| | T | ___ | R | _____ | | |
| 2. Property Controlling in Section | S | ___ | T | ___ | R | _____ |
| | S | ___ | T | ___ | R | _____ |
| 3. Miscellaneous Property in Sec. | S | ___ | T | ___ | R | _____ |
| | S | ___ | T | ___ | R | _____ |

APPROVED LAND CORNER
P.A. 345 OF 1990
Osceola County

Matthew McClung
25 July 1996

Register of Deeds Stamp & File Number

4. Lot No. _____, Recorded Plat _____
5. Private Claims _____

Matthew McClung July 8, 96

I, _____, in a field survey on _____, 19____, do hereby certify that under requirements of P.A. 74, Michigan P.A. of 1970, the corner points mentioned in lines 1 and 2 above were in conformance with regulations and rules therefore as required in the current manual of survey instructions of the United States Department of the Interior, Bureau of Land Management or by a decree of a Court of Law and/or that the corner points mentioned in lines 3, 4 and 5 above were in conformance with the rules of the Michigan Board of Land Surveyors or by a Decree of a Court of Law; established, re-established, monumented, re-monumented, recovered, found as expressed below:

NOTE: Not more than 4 corners, all in the same town and range, may be recorded on this certificate.

	A	B	C	D	E	F	G	H	I	J	K	L	M
2	6		5		4		3		2		1		
3													
4	7		8		9		10		11		12		
5													
6	18		17		16		15		14		13		
7													
8	19		20		21		22		23		24		
9													
10	30		29		28		27		26		25		
11													
12	31		32		33		34		35		36		
13													

A. Description of original monument and accessories and/or subsequent restoration:


The original corner was set by deputy surveyor Orson Lyons on July 1, 1947. Set Temp. wood post 40.00 chains from the South.
Hemlock 18" S77W 29 lks.
Beech 18" S70 1/2E 13 lks.
Sylvan Township Record Book ; front pages, page 8.

B. Description of corner evidence found and/or method applied in restoring or reestablishing corner:

Found 3" tapered x 12" Long pipe, in centerline of east and west road and 2' west of centerline in road north 8" below road surface. Removed pipe and excavated to 18" and found wood stake on east side of iron. removed wood stake and excavated to 25" and found no other evidence of corner. Placed Osceola County Monument inside 3" tapered pipe in position of wood stake 3" below road surface.

C. Description of monument for corner and accessories established to perpetuate locating the position of the corner:

Corner E-4. Osceola County Monument, which is a 3" brass cap monument on a 1" pipe 18" in length.
Telephone Pedestal N42W 40.55 feet.
28" Spruce S15E 23.37 feet O.B.P.
Power Pole S78E 116.55 feet.
NW Corner House S55E 70.72 feet. O.B.P.

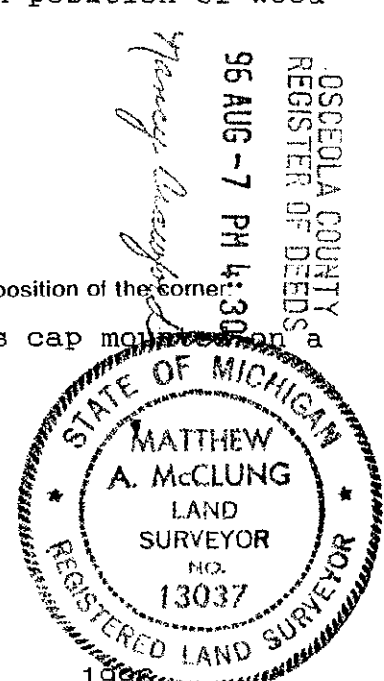

Signed by *Matthew McClung* Date July 8, 1996
Surveyor's Michigan License No. 13037