

SURVEY & REMONUMENTATION

FEB 12 1998

LAND CORNER RECORDATION CERTIFICATE
Filing Requirement of Act 74, Mich. P.A. 1970

For corners in **SECTION**

Osceola
(County)

Located In:

Corner Code #

- | | | |
|------------------------------------|---------------------------|-------------|
| 1. Public Land Survey | T <u>18</u> N <u>R7</u> W | E- <u>9</u> |
| | T___R___ | _____ |
| | T___R___ | _____ |
| | T___R___ | _____ |
| 2. Property Controlling in Section | S___T___R___ | _____ |
| | S___T___R___ | _____ |
| 3. Miscellaneous Property in Sec. | S___T___R___ | _____ |
| | S___T___R___ | _____ |

APPROVED LAND CORNER
P.A. 345 OF 1990
Osceola County

24 July 1997
Matthew A. McClung

Register of Deeds Stamp & File Number

4. Lot No. _____, Recorded Plat _____
5. Private Claims _____

Matthew McClung, in a field survey on Apr 16, 1997 do hereby state that under requirements of P.A. 74, Michigan P.A. of 1970, the corner points mentioned in lines 1 and 2 above were in conformance with regulations and rules therefore as required in the current manual of survey instructions of the United States Department of the Interior, Bureau of Land Management or by a decree of a Court of Law and/or that the corner points mentioned in lines 3, 4 and 5 above were in conformance with the rules of the Michigan Board of Land Surveyors or by a Decree of a Court of Law; established, re-established, monumented, recovered, found as expressed below:

NOTE: Not more than 2 corners, all in the same town and range, may be recorded on this certificate.

1	A	B	C	D	E	F	G	H	I	J	K	L	M
2		6		5		4		3		2		1	
3													
4		7		8		9		10		11		12	
5													
6		18		17		16		15		14		13	
7													
8		19		20		21		22		23		24	
9													
10		30		29		28		27		26		25	
11													
12		31		32		33		34		35		36	
13													

A. Description of original monument and accessories and/or subsequent restoration:

The original corner was set by deputy surveyor Orson Lyons on July 1, 1848. Set Temp. wood post 80.00 chains from the South.
Hemlock 24" S65E 45 lks.
Beech 10" S46 1/2 W 33 lks.

P.A. 74:

Liber 1, page 47

Dated 26 Jan. 1972

Corner was established by fence rows

6" Maple N85W 28.6'

B. Description of corner evidence found and/or method applied in restoring or reestablishing corner: (continued on back)

Found Osceola County Monument at surface. Corner sits 32.30 feet East of West R/W Fence Row and 33.00 West of East R/W Fence Row. The distance from E-9 to E-10 is 2625.829 and the distance from E-10 to E-11 is 2,632.34 feet. The corner is in the East and West Fence.

C. Description of monument for corner and accessories established to perpetuate locating the position of the corner:


Corner E-9. Osceola County Monument, which is a 3" brass cap mounted on a 1" pipe 18" in length.

8" Maple S94W 28.60 feet. O.B.T.

9" Maple w/nail N32W 46.90 feet.

12" Cherry S20W 25.80 feet. O.B.T.

12" R. Pine S65E 43.80 feet.

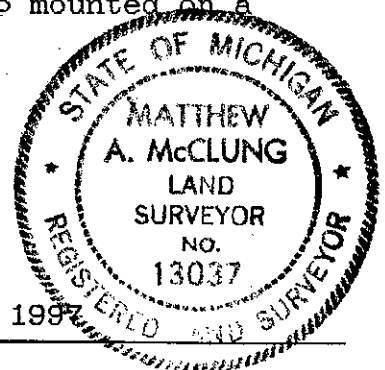

Signed by Matthew A. McClung
Surveyor's Michigan License No. 13037

Date April 16, 1997

OSCEOLA COUNTY
REGISTER OF DEEDS

97 AUG -7 AM 11:56

Nancy Crawford

Act 132:
Liber 294, page 697
Dated: 26 Jan 1972
No witnesses shown

Liber 614, Page 261
Dated: 12 Dec 1996

**SURVEY &
REMONUMENTATION**

FEB 12 1998

SECTION