

**SURVEY & REMONUMENTATION**

**FEB 12 1998**

**SECTION**

**LAND CORNER RECORDATION CERTIFICATE**  
Filing Requirement of Act 74, Mich. P.A. 1970

For corners in

Osceola

(County)

Located In:

Corner Code #

- |                                    |  |             |
|------------------------------------|--|-------------|
| 1. Public Land Survey              | T <u>18N</u> <u>7W</u>                 | <u>E-10</u> |
|                                    | T <u>   </u> <u>   </u>                | <u>   </u>  |
|                                    | T <u>   </u> <u>   </u>                | <u>   </u>  |
|                                    | T <u>   </u> <u>   </u>                | <u>   </u>  |
| 2. Property Controlling in Section | S <u>   </u> T <u>   </u> R <u>   </u> | <u>   </u>  |
|                                    | S <u>   </u> T <u>   </u> R <u>   </u> | <u>   </u>  |
| 3. Miscellaneous Property in Sec.  | S <u>   </u> T <u>   </u> R <u>   </u> | <u>   </u>  |
|                                    | S <u>   </u> T <u>   </u> R <u>   </u> | <u>   </u>  |

APPROVED LAND CORNER  
P.A. 345 OF 1990  
Osceola County

*16 Oct 1997*  
*Matthew A. McClung*

Register of Deeds Stamp & File Number

4. Lot No. \_\_\_\_\_, Recorded Plat \_\_\_\_\_  
5. Private Claims \_\_\_\_\_

I, Matthew McClung, in a field survey on Nov 16, 1997 do hereby state that under requirements of P.A. 74, Michigan P.A. of 1970, the corner points mentioned in lines 1 and 2 above were in conformance with regulations and rules therefore as required in the current manual of survey instructions of the United States Department of the Interior, Bureau of Land Management or by a decree of a Court of Law and /or that the corner points mentioned in lines 3, 4 and 5 above were in conformance with the rules of the Michigan Board of Land Surveyors or by a Decree of a Court of Law; established, re-established, monumented, recovered, found as expressed below:


NOTE: Not more than 2 corners, all in the same town and range, may be recorded on this certificate.

	A	B	C	D	E	F	G	H	I	J	K	L	M
1													
2	6		5		4		3		2		1		
3													
4	7		8		9		10		11		12		
5													
6	18		17		16		15		14		13		
7													
8	19		20		21		22		23		24		
9													
10	30		29		28		27		26		25		
11													
12	31		32		33		34		35		36		
13													

A. Description of original monument and accessories and/or subsequent restoration:

The original corner was set by deputy surveyor Orson Lyons on July 1, 1947. Set Temp. wood post 40.00 chains from the South.  
Beech 8" S21 1/2W 25 lks.  
Hemlock 22" N31E 13 lks.

continued on back

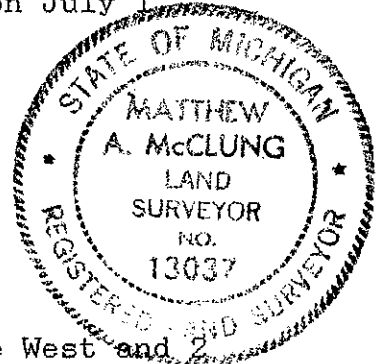

B. Description of corner evidence found and/or method applied in restoring or reestablishing corner:

Found iron and cap No. 9433 by Lapham, 4 feet North of Fence West and 2 feet North of fence East, in centerline of North and South Road, 5" below road surface. Excavated to 15" and removed iron & cap. Used magnetic locator in hole and no other evidence of corner was present. Placed Osceola County Monument in position of iron and cap 6" below road surface. The distance from E-9 to E-10 is 2625.829 feet and the Distance from E-10 to E-11 is 2,632.340 feet.

C. Description of monument for corner and accessories established to perpetuate locating the position of the corner:

Corner E-10. Osceola County Monument, which is a 3" brass cap mounted on a 1" pipe 18" in length.  
Power Pole\* N88E 49.00 feet.  
5" Maple S25E 111.15 feet.  
Fence Post S80W 31.36 feet.  
Fence Post East 33.38 feet.

\* Old telephone pole 24 feet long sits just South of power pole.

Signed by Matthew McClung  
Surveyor's Michigan License No. 13037

Date April 16, 1997

OSCEOLA COUNTY  
REGISTER OF DEEDS

97 NOV 26 AM 11:48

*Nancy Crawford*

P.A. 132, Liber 532, Page 759.  
by McClung, dated 13 June 1990.  
No witnesses given.

P.A. 132, Liber 614, Page 261.  
by McClung, Dated 11 Nov. 1996.  
Power Pole N88E 49.00 feet.  
5" Maple S25E 111.15 feet.  
Fence Post S80W 31.36 feet.  
Fence Post East 33.38 feet.

SURVEY &  
REMONUMENTATION

FEB 12 1998

SECTION