

SURVEY & REMONUMENTATION


DEC 13 2000

LAND CORNER RECORDATION CERTIFICATE

FILING REQUIREMENT OF ACT 74, Mich. P.A. 1970

SECTION

For corners in Osceola	Located in:	Corner Code#
1. Public Land Survey	T 18 N R 7 W	E-11
	T R	
	T R	
	T R	
2. Property Controlling in Section	S T R	
	S T R	
3. Miscellaneous Property in Sec.	S T R	
	S T R	
4. Lot No. _____ Recorded Plat _____		
5. Private Claims _____		

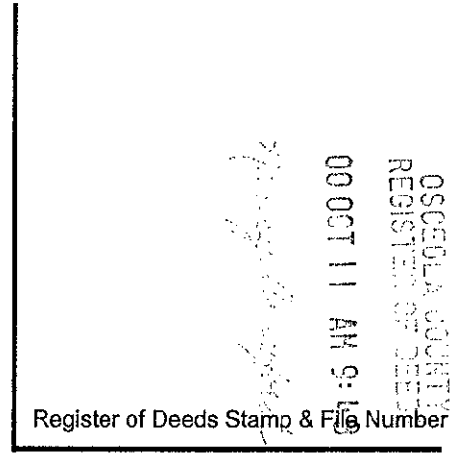

	A	B	C	D	E	F	G	H	I	J	K	L	M
1													
2	6	5	4	3	2	1							
3													
4	7	8	9	10	11	12							
5													
6	18	17	16	15	14	13							
7													
8	19	20	21	22	23	24							
9													
10	30	29	28	27	26	25							
11													
12	31	32	33	34	35	36							
13													

I, Robert L. Wetherell, in a field survey on July 19, 2000, do hereby certify that under requirements of P.A. 74, Michigan P.A. of 1970, the corner points mentioned in lines 1 and 2 above were in conformance with regulations and rules therefore as required in the current manual of survey instructions of the United States Department of the Interior, Bureau of Land Management or by decree of a Court of Law and/or that the corner points mentioned in lines 3, 4, and 5 above were in conformance with the rules of the Michigan Board of Land Surveyors or by a Decree Of a Court of Law; established, re-established, monumented, re-monumented, recovered, found as expressed below:

E-11 - Section corner common to Sections 28, 29, 32 & 33, T18N, R7W

A. Description of original monument and accessories and/or subsequent restoration:

<u>1848 - O. Lyon, G.L.O.</u>	<u>1972 - M. McClung, LS 13037</u>	<u>1999 - M. McClung, LS 13037</u>
#1 - 14" W. Ash S33°W 14 Links	L.C.R.C. - Liber 01, Pg. 150.	Survey recorded Liber 661, Pg. 241
#2 - 16" W. Ash N38½°E 26 Links	Survey recorded Liber 302, Pg. 68.	#8 - Tele. Ped. N45°E 44.1'
	Found Iron	#9 - 4" Gas Line Marker Pipe
<u>Undated - Old Co. Sur. Twp. Notes</u>	#6 Tele. Pole N.E. 44.2'	S45°E 54.1'
Page 5.	#7 - P. Pole S.E. 72.0'	#10 - 6" Cherry S70°E 62.2'
1" Pipe		
#3 - T.P. N64°W 54.5'	<u>1990 - M. McClung, LS 13037</u>	
#4 - Elm S.W. 39.7'	Survey recorded Liber 532, Pg. 759.	
#5 - 3" Maple S26½°E 67.7'	No accessories given.	

B. Description of corner evidence found and/or method applied in restoring of reestablishing corner:

I found an old 1" pipe in the intersection of roads North, South, East and West as called for in the old township notes.


Condition of the accessories are as follows: #1 Gone, #2 Gone, #3 Gone, #4 Gone, #5 Gone, #6 Gone, #7 Found in good condition, #8 Found in good condition, #9 Found in good condition (N39°E 58.01'), #10 Found in good condition (S70°W 62.2').

C. Description of monument for corner and accessories established to perpetuate locating the position of the corner:

I replaced the old 1" pipe with a 1" x 18" pipe with Osceola County Remon Cap, and is accepted as a careful and faithful reestablishment of the position of the original corner.

- 4" Gas line Marker Pipe N39°E 58.01' (center of pipe) #9
- 8" Cherry N34°E 68.04' (60d spike E. side)
- 9" Elm S15°E 108.71' (60d spike W. side)
- 4" Ash N80°E 124.37' (60d spike S. side)
- 6" Cherry S50°E 55.13' (60d spike N.E. side)

APPROVED LAND CORNER
P.A. 345 OF 1990
Osceola County
R. L. W.
8-17-2000

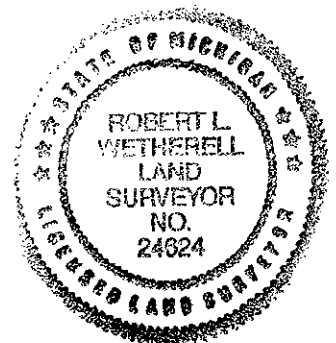

Signed by Robert L. Wetherell
Surveyor's Michigan License No. 24624

Date August 22, 2000

FORM APPROVED BY MICHIGAN STATE BOARD OF LAND SURVEYORS, JAN. 28, 1971
REVISED MAY 14, 1975
REVISED JAN. 1983
ADAPTED FOR WORD PROCESSING JANUARY, 1999