

**SURVEY &
REMONUMENTATION**

AUG 27 1996

COMMISSION

**LAND CORNER RECORDATION CERTIFICATE
Filing Requirement of Act 74, Mich. P.A. 1970**

For corners in
Osceola
(County)

Located In: 18N 7W Corner Code F-5

1. Public Land Survey	T	R	_____
	T	R	_____
	T	R	_____
	T	R	_____
2. Property Controlling in Section	S	T	_____
	S	T	_____
3. Miscellaneous Property in Sec.	S	T	_____
	S	T	_____

APPROVED LAND CORNER
P.A. 345 OF 1990
Osceola County

Matthew A. McClung
25 July 1996

Register of Deeds Stamp & File Number

4. Lot No. _____, Recorded Plat _____
5. Private Claims _____

Matthew McClung July 8, 1996

I, _____, in a field survey on _____, 19_____, do hereby certify that under requirements of P.A. 74, Michigan P.A. of 1970, the corner points mentioned in lines 1 and 2 above were in conformance with regulations and rules therefore as required in the current manual of survey instructions of the United States Department of the Interior, Bureau of Land Management or by a decree of a Court of Law and/or that the corner points mentioned in lines 3, 4 and 5 above were in conformance with the rules of the Michigan Board of Land Surveyors or by a Decree of a Court of Law; established, re-established, monumented, re-monumented, recovered, found as expressed below:

NOTE: Not more than 4 corners, all in the same town and range, may be recorded on this certificate.

	A	B	C	D	E	F	G	H	I	J	K	L	M
2	6	5	4	3	2	1							
3													
4	7	8	9	10	11	12							
5													
6	18	17	16	15	14	13							
7													
8	19	20	21	22	23	24							
9													
10	30	29	28	27	26	25							
11													
12	31	32	33	34	35	36							
13													

A. Description of original monument and accessories and/or subsequent restoration:

The original corner was set by deputy surveyor Orson Lyons on July 1, 1847. Set temp. wood post 39.95 chains from the East.
Hemlock 24" S31E 18 lks.
Hemlock 12" N47 1/2 W 13 lks.

I have shown 2 LCRC certificates; Liber 2, Page 218; Liber 2, Page 139.

Sylvan Township Record Book Pages 36 and 37.
Found old Corner Post (down) North 32.20 feet.


B. Description of corner evidence found and/or method applied in restoring or reestablishing corner:

Found 1/2" Iron Rebar in centerline of East and West road, 3" below surface. Excavated to 25" and found remnants of wooden stake in hole. Placed Osceola County Monument in position of 1/2" Iron rebar 6" below surface. Corner is in line with fence row coming from North. Fence stops about 1/4 mile to North. Found old corner post (down) North 32.20 feet.

C. Description of monument for corner and accessories established to perpetuate locating the position of the corner:

Corner F-5. Osceola County Monument, which is a 3" brass cap mounted on a 1" pipe 18" in length.
12" Cedar in clump of 3 with/ nail S52E 47.30 feet. O.B.P.
5" Ash W/Nail South 33.30 feet. O.B.P.
20" Cedar S78E 137.10 feet.
5" Spruce S62E 57.05 feet.

Francis Campbell
96 AUG - 7 PM 4:30
OSCEOLA COUNTY
REGISTER OF DEEDS

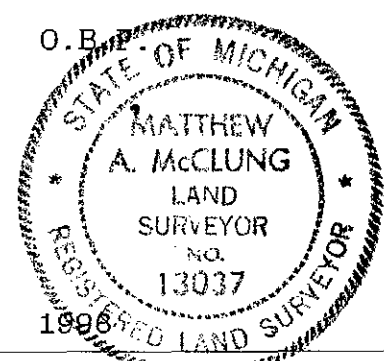

Signed by Matthew A. McClung Date July 8, 1996
Surveyor's Michigan License No. 13037