

LAND CORNER RECORDATION CERTIFICATE
Filing Requirement of Act 74, Mich. P.A. 1970

**SURVEY &
REMONUMENTATION**

NOV 01 1999

SECTION

For corners in

Osceola

(County)

Located in:

Corner Code #

1. Public Land Survey

T 18N 7W G-13
 T R
 T R
 T R
 T R

2. Property Controlling in Section

S T R
 S T R

3. Miscellaneous Property in Sec.

S T R
 S T R

Register of Deeds Stamp & File Number

4. Lot No. _____, Recorded Plat _____

5. Private Claims _____

I, Robert L. Wetherell, in a field survey on Aug 1, 1999 do hereby state that under requirements of P.A. 74, Michigan P.A. of 1970, the corner points mentioned in lines 1 and 2 above were in conformance with regulations and rules therefore as required in the current manual of survey instructions of the United States Department of the Interior, Bureau of Land Management or by a decree of a Court of Law and/or that the corner points mentioned in lines 3, 4 and 5 above were in conformance with the rules of the Michigan Board of Land Surveyors or by a Decree of a Court of Law, established, re-established, monumented, recovered, found as expressed below:

NOTE: Not more than 2 corners, all in the same town and range, may be recorded on this certificate.

	A	B	C	D	E	F	G	H	I	J	K	L	M
1													
2	6	5	4	3	2	1							
3													
4	7	8	9	10	11	12							
5													
6	18	17	16	15	14	13							
7													
8	19	20	21	22	23	24							
9													
10	30	29	28	27	26	25							
11													
12	31	32	33	34	35	36							
13													

A. G-13 - SE Corner of Section 34, T18N, R7W
Description of original monument and accessories and/or subsequent restoration:

1848 - O. Lyon
#1 - 10" Tamarack N45W 30 Links
#2 - 7" Tamarack S25W 30 Links

1891 - 1904 - A. Temple/F. Trumbull
Remonumentation of T17N, R7W
Set 3" Clay
"Stone and Crockery"
#3 - SW Cor. School House
N40E 140 Links

(SEE OVER FOR CONTINUATION OF "A")

B. Description of corner evidence found and/or method applied in restoring or reestablishing corner:

I found a 1/2" Iron and Cap (marked LS24624) in Monument Box at the intersection C/L's of M-66 and US 10.

Condition of the accessories are as follows: #1 Gone, #2 Gone, #3 Gone, #4 Gone, #5 Gone, #6 Gone, #7 Found in good condition, #8 Found in good condition, #9 and #7 Found in good condition. And #10 Found in good condition.

Corner common to G-1 of T17N R7W

C. Description of monument for corner and accessories established to perpetuate locating the position of the corner:

I accepted the 1/2" iron in the Monument Box as substantial marker for the corner and is accepted as a careful and faithful re-establishment of the Position of the original corner.

P. Pole (Nail in N. W. side) N40E 77.05' #10
 P. Pole (Nail in S. W. side) S20E 142.06' #9
 P. Pole (Nail in S. E. side) S55W 90.50' #8
 Telephone Ped. (Top center 4.') N22W 87.35'
 MDOT Control Monument S23E 98.34'


Signed by Robert L. Wetherell
24624

Date 8-26-99

Surveyor's Michigan License No. _____

APPROVED LAND CORNER
P.A. 345 OF 1990
Osceola County

R.L.W.
8-26-99

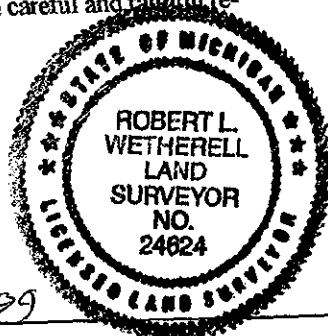

CONTINUATION OF DESCRIPTION OF ORIGINAL MONUMENT AND ACCESSORIES AND/OR SUBSEQUENT RESTORATION.

Undated-Orient Twp. Book

Page 8 Front of book

Cor. 3, 4, 33, & 34

#4 - T.P. S49W 39.5' (On S. T. P. Line)

#5 - T.P. S82E 22.94 (On S.T. P. Line)

Undated-Sylvan Twp. Book

Page 3, Front of book

E. 1/2 33-4 2618.4'

1957 State Highway Dept.

Shows Corner

1964 - M. McClung Sylvan Twp. Book

Page 52 and 54

#6 - P. Pole N46E 73.39'

#7 - T. P. NW 85.0'

1979 - Lapham LS 9433

L.C.R.C. L. 2, Pg. 137

Set Nail & Tag 3.73' East on C/L

#8 - T. Pole S45W 90.55'

#7 - T. Pole N45W 84.35'

#9 - P. Pole S45E 142.45'

#10 - P. Pole N45E 77.15'

1981 - McClung LS 13037

L.C.R.C.

L. 2, Pg. 206

Fd. Mon. box in M-66 and US 10.

1998 - Wetherell LS 24624

#8 - T. Pole S45W 90.55'

#7 - T. Pole N45W 84.35'

#9 - P. Pole S45E 142.45'

#10 - P. Pole N45E 77.15'

James Crawford

OSCEOLA COUNTY
REGISTER OF DEEDS
99 SEP -3 AM 11:48

SURVEY &
REMONUMENTATION

NOV 01 1999

SECTION