

**SURVEY &
REMONUMENTATION**

AUG 27 1996

**LAND CORNER RECORDATION CERTIFICATE
Filing Requirement of Act 74, Mich. P.A. 1970**

COMMISSION

For corners in

<u>Osceola</u> <small>(County)</small>	Located In:	Corner Code #
	18N 7W	I-4
1. Public Land Survey	T ___ R ___	_____
	T ___ R ___	_____
	T ___ R ___	_____
	T ___ R ___	_____
2. Property Controlling in Section	S ___ T ___ R ___	_____
	S ___ T ___ R ___	_____
3. Miscellaneous Property in Sec.	S ___ T ___ R ___	_____
	S ___ T ___ R ___	_____

APPROVED LAND CORNER
P.A. 345 OF 1990
Osceola County

Matthew McClung
25 July 1996

Register of Deeds Stamp & File Number

4. Lot No. _____, Recorded Plat _____
5. Private Claims _____

A	B	C	D	E	F	G	H	I	J	K	L	M
2	6	5	4	3	2	1						
3												
4	7	8	9	10	11	12						
5												
6	18	17	16	15	14	13						
7												
8	19	20	21	22	23	24						
9												
10	30	29	28	27	26	25						
11												
12	31	32	33	34	35	36						
13												

Matthew McClung July 28 1995

I, _____, in a field survey on _____, 19____, do hereby certify that under requirements of P.A. 74, Michigan P.A. of 1970, the corner points mentioned in lines 1 and 2 above were in conformance with regulations and rules therefore as required in the current manual of survey instructions of the United States Department of the Interior, Bureau of Land Management or by a decree of a Court of Law and/or that the corner points mentioned in lines 3, 4 and 5 above were in conformance with the rules of the Michigan Board of Land Surveyors or by a Decree of a Court of Law; established, re-established, monumented, re-monumented, recovered, found as expressed below:

NOTE: Not more than 4 corners, all in the same town and range, may be recorded on this certificate.

A. Description of original monument and accessories and/or subsequent restoration:

The original corner was set by deputy surveyor Orson Lyons on July 1, 1848. Set wood post 40.00 chains from South.
Hemlock 10" N36E 13 Lks
Hemlock 26" N47W 13 Lks.

Survey sketch by Batzer.


B. Description of corner evidence found and/or method applied in restoring or reestablishing corner:

Found 1 1/4" pipe as shown on survey by Batzer. Found Monument and pipe, as shown on sketch of Batzer Survey. Measured 1332.18 as shown (rough taped).

Matthew McClung
96 AUG - 7 PM 4:30
OSCEOLA COUNTY
REGISTER OF DEEDS

C. Description of monument for corner and accessories established to perpetuate locating the position of the corner:

Corner I-4. Osceola County Monument, which is a 3" brass cap mounted on a 1" pipe 18" in length.
10" Cherry In a clump of four N56W 54.3 feet.
6" Maple S08E 13.4 feet.
5" Maple North 14.28 feet.
15" Maple N76E 7.30 feet. O.B.T.

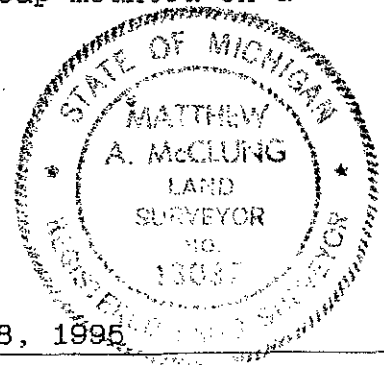

Signed by *Matthew McClung* Date July 28, 1995
Surveyor's Michigan License No. 13037