

NOV 15 1994

LAND CORNER RECORDATION CERTIFICATE
Filing Requirement of Act 74, Mich. P.A. 1970

For corners in

COMMISSION

Osceola
(County)

Located In:

Corner Code #

1. Public Land Survey T18N R7W J-11
 T R
 T R
 T R
2. Property Controlling S T R
 in Section S T R
 3. Miscellaneous S T R
 Property in Sec. S T R
4. Lot No. , Recorded Plat
 5. Private Claims

APPROVED LAND CORNER
P.A. 345 OF 1990
Osceola County

Matthew A. McClung
Oct. 11, 1994

Register of Deeds Stamp & File Number

I, Matthew McClung in a field survey on October 3, 191994, do hereby certify that under requirements of P.A. 74, Michigan P.A. of 1970, the corner points mentioned in lines 1 and 2 above were in conformance with regulations and rules therefore as required in the current manual of survey instructions of the United States Department of the Interior, Bureau of Land Management or by a decree of a Court of Law and/or that the corner points mentioned in lines 3, 4 and 5 above were in conformance with the rules of the Michigan Board of Land Surveyors or by a Decree of a Court of Law; established, re-established, monumented, re-monumented, recovered, found as expressed below:

	A	B	C	D	E	F	G	H	I	J	K	L	M
2	6	5	4	3	2	1							
3													
4	7	8	9	10	11	12							
5													
6	18	17	16	15	14	13							
7													
8	19	20	21	22	23	24							
9													
10	30	29	28	27	26	25							
11													
12	31	32	33	34	35	36							
13													

NOTE: Not more than 4 corners, all in the same town and range, may be recorded on this certificate.

A. Description of original monument and accessories and/or subsequent restoration:

The original corner was set by deputy surveyor Orson Lyons on 14 April 1847. Set wood post 40.375 chains from East.
 Cedar 10" S40E 19.5 lks.
 Lynn 7" S69 1/2E 17 lks.


The corner has an LCRC Liber 2, page 371 by McClung

A Pa 132 Liber 521, Page 533.

A. Continued on back.

B. Description of corner evidence found and/or method applied in restoring or reestablishing corner:

Found 1" pipe next to 8" X 8" stone at road surface. Removed pipe, 8" long, and set Osceola County Monument 6" below surface. Replaced pipe on North side of Monument, flush with Monument. Corner is in road centerline.

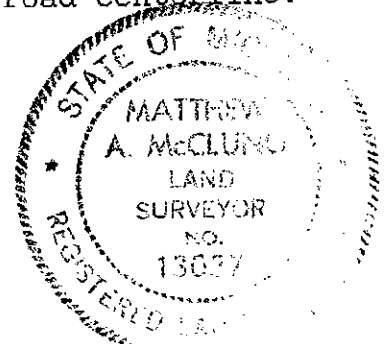

C. Description of monument for corner and accessories established to perpetuate locating the position of the corner:

Corner I-11. Osceola County Monument, which is a 3" brass cap mounted on a 1" pipe 18" in length.
 10" Scotch Pine N20E 55.7 feet O.B.T.
 Power pole South 82.15 feet O.B.P..
 Intermittent row of planted spruce trees South.
 6" R. Pine N30W 95.45 feet.

Signed by *Matthew A. McClung*

Date October 3, 1994

Surveyor's Michigan License No. 13037

OSCEOLA COUNTY
REGISTER OF DEEDS

94 NOV -4 PM 2:48

Nancy Crawford

This Corner is recorded in the Township Book, front pages as: Stone-
Larch N53W 45.1 feet and Fence Post N1/2E 27.3 feet

SURVEY &
REMONUMENTATION

NOV 15 1994

COMMISSION