

NOV 15 1994

COMMISSION

LAND CORNER RECORDATION CERTIFICATE  
Filing Requirement of Act 74, Mich. P.A. 1970

For corners in

<u>Osceola</u> (County)	Located In:	Corner Code #
1. Public Land Survey	T <u>18N</u> R <u>7W</u>	<u>K-11</u>
	T _____ R _____	_____
	T _____ R _____	_____
	T _____ R _____	_____
2. Property Controlling in Section	S _____ T _____ R _____	_____
	S _____ T _____ R _____	_____
3. Miscellaneous Property in Sec.	S _____ T _____ R _____	_____
	S _____ T _____ R _____	_____

APPROVED LAND CORNER  
P.A. 345 OF 1990  
Osceola County

*Matthew McClung*  
October 11, 1994

Register of Deeds Stamp & File Number

4. Lot No. \_\_\_\_\_, Recorded Plat \_\_\_\_\_  
5. Matthew McClung October 3 1994

	A	B	C	D	E	F	G	H	I	J	K	L	M
2	6	5	4	3	2	1							
3													
4	7	8	9	10	11	12							
5													
6	18	17	16	15	14	13							
7													
8	19	20	21	22	23	24							
9													
10	30	29	28	27	26	25							
11													
12	31	32	33	34	35	36							
13													

I, \_\_\_\_\_, in a field survey on \_\_\_\_\_, 19\_\_\_\_, do hereby certify that under requirements of P.A. 74, Michigan P.A. of 1970, the corner points mentioned in lines 1 and 2 above were in conformance with regulations and rules therefore as required in the current manual of survey instructions of the United States Department of the Interior, Bureau of Land Management or by a decree of a Court of Law and/or that the corner points mentioned in lines 3, 4 and 5 above were in conformance with the rules of the Michigan Board of Land Surveyors or by a Decree of a Court of Law; established, re-established, monumented, re-monumented, recovered, found as expressed below:

NOTE: Not more than 4 corners, all in the same town and range, may be recorded on this certificate.


A. Description of original monument and accessories and/or subsequent restoration:

The original corner was set by deputy surveyor Orson Lyons on 14 April 1847. Set wood post 80.00 chains from South.  
Hemlock 14" N36 1/2E 11 lks.  
Hemlock 16" S27 1/2E 14 lks.

The corner has an LCRC Liber 2, page 371 by McClung  
Front pages of Township Book 3rd page from index.

B. Description of corner evidence found and/or method applied in restoring or reestablishing corner:

Found 1" pipe 18" long at road surface. Removed 1" pipe and placed Osceola County Monument in the position. Reset 1" pipe on South side of Monument, flush with cap, 6" below road surface.

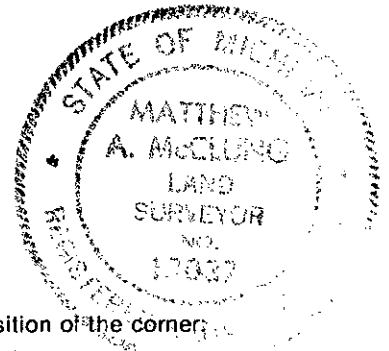

C. Description of monument for corner and accessories established to perpetuate locating the position of the corner:

Corner G-11. Osceola County Monument, which is a 3" brass cap mounted on a 1" pipe 18" in length.  
Power pole N60W 52.25 feet. O.B.P.  
Telephone Pedestal N45E 47.75 feet O.B.P.  
Telephone Pedestal S35E 37.92 feet. O.B.P.  
2" Pipe Gate post S15E 44.43 feet.

*Mary Crawford*  
94 NOV - 4 PM 2:48  
OSCEOLA COUNTY  
REGISTER OF DEEDS

Signed by *Matthew McClung* Date October 3, 1994  
Surveyor's Michigan License No. 13037