

**SURVEY &
MONUMENTATION**

**LAND CORNER RECORDATION CERTIFICATE
Filing Requirement of Act 74, Mich. P.A. 1970**

AUG 27 1996

For corners in
Osceola
(County)

Located in: 18N 7W Corner Code L-1

- | | | | |
|------------------------------------|---|---|-------|
| 1. Public Land Survey | T | R | _____ |
| | T | R | _____ |
| | T | R | _____ |
| | T | R | _____ |
| 2. Property Controlling in Section | S | T | R |
| | S | T | R |
| 3. Miscellaneous Property in Sec. | S | T | R |
| | S | T | R |

COMMISSION

APPROVED LAND CORNER
P.A. 345 OF 1990
Osceola County

Matthew McClung
25 July 1996

Register of Deeds Stamp & File Number

4. Lot No. _____, Recorded Plat _____

5. Private Claims (SAME AS T19N, R7W L-13)

Matthew McClung July 8, 1996

I, _____, in a field survey on _____, 19_____, do hereby certify that under requirements of P.A. 74, Michigan P.A. of 1970, the corner points mentioned in lines 1 and 2 above were in conformance with regulations and rules therefore as required in the current manual of survey instructions of the United States Department of the Interior, Bureau of Land Management or by a decree of a Court of Law and/or that the corner points mentioned in lines 3, 4 and 5 above were in conformance with the rules of the Michigan Board of Land Surveyors or by a Decree of a Court of Law; established, re-established, monumented, re-monumented, recovered, found as expressed below:

NOTE: Not more than 4 corners, all in the same town and range, may be recorded on this certificate.

	A	B	C	D	E	F	G	H	I	J	K	L	M
2	6	5	4	3	2	1							
3													
4	7	8	9	10	11	12							
5													
6	18	17	16	15	14	13							
7													
8	19	20	21	22	23	24							
9													
10	30	29	28	27	26	25							
11													
12	31	32	33	34	35	36							
13													

A. Description of original monument and accessories and/or subsequent restoration:

The original corner was set by deputy surveyor John Hodgson on Dec. 9, 1937. Set temp. wood post 40.00 chains from the East.
36" Pine for 1/4 Section Post.


From 1891 to 1904 approximately, Osceola County had a remonumentation program, in which surveyors Temple and Trumbull, did the work. For the most part, a 3" glazed tile filled with cinders from a forge, were placed at each government set corner in the township. There were supposed to be 3 tile per corner, placed atop of each other, (continued on back)

B. Description of corner evidence found and/or method applied in restoring or reestablishing corner:

Found 1/2" Re rod and Cap in center of tile 2" above ground surface. Placed Osceola County Monument 30" in length over rered 3" above surface. Corner is about 2 1/2" North and 1/2" West of cedar post. Used Witnesses on Roser Certificate.

C. Description of monument for corner and accessories established to perpetuate locating the position of the corner:

Corner L-1. Osceola County Monument, which is a 3" brass cap mounted on 1" pipe 30" in length.
23" Maple N80W 21.37 feet O.B.P.
5" R. Oak N40W 31.28 feet.
5" Maple N25E 34.78 feet.
11" Maple S20W 7.63 feet. O.B.P.

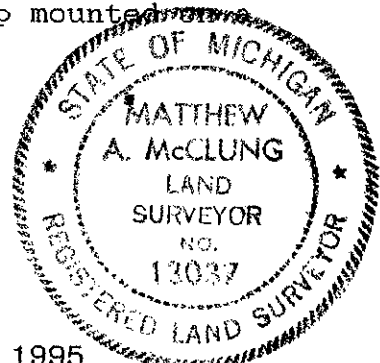

Signed by Matthew McClung

Date July 20, 1995

Surveyor's Michigan License No. 13037

OSCEOLA COUNTY
REGISTER OF DEEDS

96 AUG -7 PM 4:30

Nancy Crawford

thereby making the corner 4 feet long. Sometimes a solid tile, with a cross in the top was used, and sometimes a 1/2" iron bars were added to the tile. Notes of the work were kept in ledgers, and given to the townships, and 5 of the townships have been recorded in the County records.

I have shown 4 132 PA survey certificates; Liber 519, Page 658; Liber 326, page 178; Liber 418, Page 21; Liber 410, Page 659.

I have shown 1 LCRC certificate; Liber 3, Page 114.

Middle Branch Township Record Book Pages 10 and 11.