

DEC 13 2000

SECTION

**LAND CORNER RECORDATION CERTIFICATE**  
 FILING REQUIREMENT OF ACT 74, Mich. P.A. 1970

For corners in <u>Osceola</u>	Located in:	Corner Code#
1. Public Land Survey	<u>T 18 N</u> <u>R 8 W</u>	<u>B-7</u>
	<u>T</u> <u>R</u>	
	<u>T</u> <u>R</u>	
	<u>T</u> <u>R</u>	
2. Property Controlling S in Section	<u>T</u> <u>R</u>	
	<u>S</u> <u>T</u> <u>R</u>	
3. Miscellaneous Property in Sec.	<u>S</u> <u>T</u> <u>R</u>	
	<u>S</u> <u>T</u> <u>R</u>	
4. Lot No. _____ Recorded Plat _____		
5. Private Claims _____		

OSCEOLA COUNTY  
 REGISTER OF DEEDS  
 00 OCT 11 AM 9:48

Register of Deeds Stamp & File Number

	A	B	C	D	E	F	G	H	I	J	K	L	M
1													
2	6	5	4	3	2	1							
3													
4	7	8	9	10	11	12							
5													
6	18	17	16	15	14	13							
7													
8	19	20	21	22	23	24							
9													
10	30	29	28	27	26	25							
11													
12	31	32	33	34	35	36							
13													

I, Robert L. Wetherell, in a field survey on, April 21, 2000, do hereby certify that under requirements of P.A. 74, Michigan P.A. of 1970, the corner points mentioned in lines 1 and 2 above were in conformance with regulations and rules therefore as required in the current manual of survey instructions of the United States Department of the Interior, Bureau of Land Management or by decree of a Court of Law and/or that the corner points mentioned in lines 3, 4, and 5 above were in conformance with the rules of the Michigan Board of Land Surveyors or by a Decree Of a Court of Law; established, re-established, monumented, re-monumented, recovered, found as expressed below:

**B-7 - 1/4 Corner common to Sections 18 & 19, T18N, R8W**

**A. Description of original monument and accessories and/or subsequent restoration:**

1848 - O. Lyon, G.L.O.  
 #1 - 8" Cedar N36°W 42 Links  
 #2 - 20" Cedar S14°E 3 Links

1905 - From Co. Sur. Twp. Notes  
 Pg. 26  
 3 - Distance West = 2191.20'

1977 - K. Ostling - D.N.R. - LS 10068  
 "Found Iron and Tile 4' below road fill".  
 Raised with steel fence post.  
 #7 - 3" Oak N75°E 44.5'  
 #8 - 9" Cedar S10°W 22.5'  
 #9 - Cedar Post North 33'

1894 - 1904 - Temple/Trumbull/June  
 Remonumented T18N R8W with  
 3" Clay tiles with cinders

1937 - From Co. Sur. Twp. Notes  
 Pages 56 & 57  
 Iron & Stake  
 #4 - 8" Elm North 30.5'  
 #5 - 6" Elm N.W. 34'  
 #6 - Distance East = 2633'

1998 - R. L. Wetherell, LS 24624  
 Survey recorded Liber 640, Pg. 82.  
 #8 - 10" Cedar S14°W 22.85'  
 #10 - 13" Hemlock S65°W 81.69'  
 #11 - 10" Elm N71°W 55.87'  
 #12 - 9" Apple N74°E 73.60'  
 #13 - 5" Tw. Maple N79°E 68.44'

**B. Description of corner evidence found and/or method applied in restoring of reestablishing corner:**

I found the "T" Iron Fence Post of K. Ostling 3 feet more or less below road surface in centerline of east and west seasonal road.


Condition of the accessories are as follows: #1 Gone, #2 Gone, #3 2188.20' (D.N.R.), #4 Gone, #5 Gone, #6 Measured 2629.90', #7 Gone, #8 Found in good condition, #9 Found in good condition, #10 Found in good condition #11 Found dead, #12 Found in good condition, #13 Found in good condition.

**C. Description of monument for corner and accessories established to perpetuate locating the position of the corner:**

I set a 1" x 18" Pipe with Osceola County Remon Cap directly over the steel fence post, and is accepted as a careful and faithful reestablishment of the position of the original corner.

- 10" Cedar S14°W 22.85' (60d spike W. side) #8
- 13" Hemlock S65°W 81.69' (60d spike W. side) #10
- 9" Apple N74°E 73.60' (60d spike N. side) #12
- 5" Tw. Maple N79°E 68.44' (60d spike S. side) #13
- 12" Ash N26°E 22.70' (60d spike E. side)

APPROVED LAND CORNER  
 P.A. 345 OF 1990  
 Osceola County  
R. L. W.  
8-17-2000

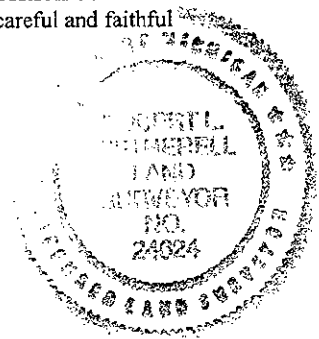

Signed by Robert L. Wetherell  
 Surveyor's Michigan License No. 24624

Date August 22, 2000