

SURVEY & REMONUMENTATION

DEC 13 2000

SECTION LAND CORNER RECORDATION CERTIFICATE
 FILING REQUIREMENT OF ACT 74, Mich. P.A. 1970

For corners in Osceola Located in: Corner Code#

1. Public Land Survey T 18 N R 8 W C-8
T R
T R
T R

2. Property Controlling S T R
 in Section S T R

3. Miscellaneous S T R
 Property in Sec. S T R

4. Lot No. Recorded Plat

5. Private Claims

OSCEOLA COUNTY
 REGISTER OF DEEDS
 00 NOV - 2 PM 4: 12
Mary Campbell
 Register of Deeds Stamp & File Number

	A	B	C	D	E	F	G	H	I	J	K	L	M
1													
2	6	5	4	3	2	1							
3													
4	7	8	9	10	11	12							
5													
6	18	17	16	15	14	13							
7													
8	19	20	21	22	23	24							
9													
10	30	29	28	27	26	25							
11													
12	31	32	33	34	35	36							
13													

I, Robert L. Wetherell, in a field survey on September 18, 2000, do hereby certify that under requirements of P.A. 74, Michigan P.A. of 1970, the corner points mentioned in lines 1 and 2 above were in conformance with regulations and rules therefore as required in the current manual of survey instructions of the United States Department of the Interior, Bureau of Land Management or by decree of a Court of Law and/or that the corner points mentioned in lines 3, 4, and 5 above were in conformance with the rules of the Michigan Board of Land Surveyors or by a Decree Of a Court of Law; established, re-established, monumented, re-monumented, recovered, found as expressed below:

C-8 - 1/4 Corner common to Sections 19 & 20, T18N, R8W

- A. Description of original monument and accessories and/or subsequent restoration:**
- | | | |
|--|--|--|
| 1848 - O. Lyon, G.L.O. | 1983 - R.L. Wetherell, LS 24624 | 1998 - R.L. Wetherell, LS 24624 |
| #1 - 14" Hemlock S28°E 13 Links | L.C.R.C. - Liber 02, Pg. 220 | Survey recorded Liber 640, Pg. 82. |
| #2 - 12" Beech N64°W 18 Links | Set corner by single proportionate method. | "Discovered that I had used wrong Sec. corner to the North to set corner in 1983". Reset corner 0.97' South and 0.38' West of the 1983 position. |
| 1894-1904 - Temple/Trumbull | #3 - P. Pole N31°W 55.93' | #6 - 15" Cedar N28°E 74.69' |
| Remonumented T18N, R8W with 3" Clay Tiles. | #4 - 6" W. Pine N58°E 31.87' | #7 - 10" Maple S89°E 68.50' |
| | #5 - 6" Maple S50°E 48.80' | #8 - 10" Cherry N65°W 71.83' |
| | | #3 - P. Pole N28°W 56.70' |


B. Description of corner evidence found and/or method applied in restoring or reestablishing corner:
 I found the 1/2" capped iron I set in 1998. Corner is in the center of road running North and South and in line with center of old roadbed (with right of way fences) running to the West. I excavated the entire road intersection with a backhoe searching for the clay tile, but was unsuccessful. I accepted the single proportionate position. This position also fits reasonably well with 1/16-line fences North and South. Distance North and South to the Section corners are 2627.96 feet.

Condition of the accessories are as follows: #1 Gone, #2 Gone, #3 Found in good condition, #4 Found in good condition, #5 Found in good condition, #6 Found in good condition, #7 Found in good condition, #8 Found in good condition.

C. Description of monument for corner and accessories established to perpetuate locating the position of the corner:
 I replaced the 1/2" iron with a 1" x 18" Iron Pipe with an Osceola Co. Remon Cap, and is accepted as a careful and faithful reestablishment of the position of the original corner.

- 15" Cedar N28°E 74.69' (60d spike E. side) #6
- 10" Maple S89°E 68.50' (60d spike N. side) #7
- 8" Maple S47°E 48.21' (60d spike S.W. side) #5
- 10" Cherry N65°W 71.83' (60d spike S. side) #8

APPROVED LAND CORNER
 P.A. 345 OF 1990
 Osceola County
R.L.W.
10-31-2000

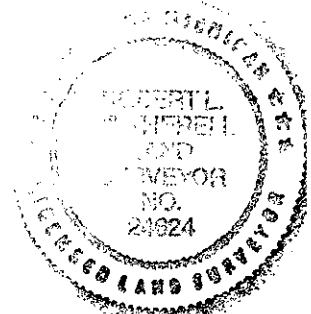

Signed by Robert L. Wetherell Date November 1, 2000
 Surveyor's Michigan License No. 24624

FORM APPROVED BY MICHIGAN STATE BOARD OF LAND SURVEYORS, JAN. 28, 1971
 REVISED MAY 14, 1975
 REVISED JAN. 1983
 ADAPTED FOR WORD PROCESSING JANUARY, 1999