

SURVEY &  
REMONUMENTATION

NOV 15 1994

COMMISSION

LAND CORNER RECORDATION CERTIFICATE

Filing Requirement of Act 74, Mich. P.A. 1970

For corners in

Osceola

(County)

Located In:

Corner Code #

- |                                       |   |     |   |    |     |
|---------------------------------------|---|-----|---|----|-----|
| 1. Public Land Survey                 | T | 18N | R | 8W | E-3 |
|                                       | T |     | R |    |     |
|                                       | T |     | R |    |     |
|                                       | T |     | R |    |     |
| 2. Property Controlling in Section    | S |     | T |    | R   |
|                                       | S |     | T |    | R   |
| 3. Miscellaneous Property in Sec.     | S |     | T |    | R   |
|                                       | S |     | T |    | R   |
| 4. Lot No. _____, Recorded Plat _____ |   |     |   |    |     |
| 5. Private Claims _____               |   |     |   |    |     |

APPROVED LAND CORNER  
P.A. 345 OF 1990  
Osceola County

*Matthew McClung*  
October 11, 1994

Register of Deeds Stamp & File Number

I, Matthew McClung a field survey on June 12, 19 1994, do hereby certify that under requirements of P.A. 74, Michigan P.A. of 1970, the corner points mentioned in lines 1 and 2 above were in conformance with regulations and rules therefore as required in the current manual of survey instructions of the United States Department of the Interior, Bureau of Land Management or by a decree of a Court of Law and/or that the corner points mentioned in lines 3, 4 and 5 above were in conformance with the rules of the Michigan Board of Land Surveyors or by a Decree of a Court of Law; established, re-established, monumented, re-monumented, recovered, found as expressed below:

**NOTE: Not more than 4 corners, all in the same town and range, may be recorded on this certificate.**

A	B	C	D	E	F	G	H	I	J	K	L	M
2	6	5	4	3	2	1						
3												
4	7	8	9	10	11	12						
5												
6	18	17	16	15	14	13						
7												
8	19	20	21	22	23	24						
9												
10	30	29	28	27	26	25						
11												
12	31	32	33	34	35	36						
13												

A. Description of original monument and accessories and/or subsequent restoration:

The original corner was set by deputy surveyor Orson Lyon on April 14, 1847. Set wood post 80.00 chains from the South.

- Beech 12" N55E 20 lks.
- Beech 10" S52W 46 lks.


From 1891 to 1904 approximately, Osceola County had a remonumentation program, in which surveyors Temple and Trumbull, did the work. For the most part, a 3" glazed tile filled with cinders from a forge, were placed at each government set corner in the township. There were supposed to be 3 tile per corner, placed atop of each other, (continued on back)

B. Description of corner evidence found and/or method applied in restoring or reestablishing corner:

I set this corner from 2 corner fence posts (down) on road R/w to west. The distance between the posts is 66.70 feet. I measured 46.90 feet from each fence post, NW and SW. Corner is in down fence to east. Corner is in road cut, 3.5 feet deep to road surface. Set Osceola County Monument 6" below road, in centerline of road

C. Description of monument for corner and accessories established to perpetuate locating the position of the corner:

- Corner E-3. Osceola County Monument, which is a 3" brass cap mounted on a 1" pipe 18" in length.
- 18" Maple N55W 45.56 feet.
- 20 S. Maple S40W 51.03 feet.
- 24" W. Oak East 41.30 feet.
- SW Corner of block cabin N55E 75.81 feet.

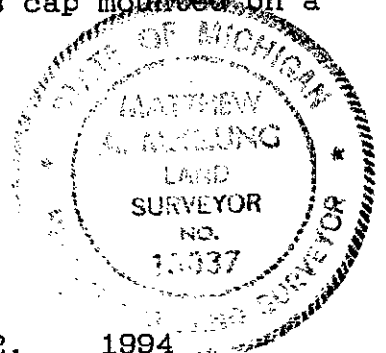

Signed by *Matthew McClung*

Date June 12, 1994

Surveyor's Michigan License No. 13037

thereby making the corner 4 feet long. Sometimes a solid tile, with a cross in the top was used, and sometimes a 1/2" iron bars were added to the tile. Notes of the work were kept in ledgers, and given to the townships, and 5 of the townships have been recorded in the County records.

One record from Osceola Township book, no identification or witnesses to corner.

OSCEOLA COUNTY  
REGISTER OF DEEDS

94 NOV -4 PM 2:47

*Mary Crawford*

SURVEY &  
REMONUMENTATION

NOV 15 1994

COMMISSION