

FEB 24 2000

SECTION

LAND CORNER RECORDATION CERTIFICATE
Filing Requirement of Act 74, Mich. P.A. 1970

For corners in
Osceola

Located In: Corner Code #

1. Public Land Survey	T 18N R 8W	F-6
	T R	
	T R	
	T R	
2. Property Controlling in Section	S T R	
	S T R	
3. Miscellaneous Property in Sec.	S T R	
	S T R	

OSCEOLA COUNTY
REGISTER OF DEEDS
99 NOV 19 PM 12:09
Mary Campbell

Register of Deeds Stamp & File Number

4. Lot No. _____, Recorded Plat _____
5. Private Claims _____

I, Robert L. Wetherell, in a field survey on Aug 12, 19 99 do hereby state that under requirements of P.A. 74, Michigan P.A. of 1970, the corner points mentioned in lines 1 and 2 above were in conformance with regulations and rules therefore as required in the current manual of survey instructions of the United States Department of the Interior, Bureau of Land Management or by a decree of a Court of Law and/or that the corner points mentioned in lines 3, 4 and 5 above were in conformance with the rules of the Michigan Board of Land Surveyors or by a Decree of a Court of Law; established, re-established, monumented, recovered, found as expressed below:

NOTE: Not more than 2 corners, all in the same town and range, may be recorded on this certificate.

F-6 - Center of Section 16, T18N, R8W

A. Description of original monument and accessories and/or subsequent restoration:

Undated - Osceola Township Book

- "Rod"
- #1 - 14" Maple S82 1/2 E 32.0'
- #2 - 12" Maple N11W 60 1/2'

1987 C. Cole LS 17615

- Survey Rec. Fd. Iron Bar
- #1- 36" Maple S80E 31.85'
- #3 - 20" Maple S35E 46.77'
- #4- Fence Post N87W 44.28'

1998 McClung LS 13037

- Survey Rec. L 638, Page 232
- Fd. 1" Sq. Shaft
- #5 - 36" Maple N16W 33.5'
- #6 - E. Cor. Of cement Dr. N44W 22.09'
- #7 - 24" Maple S50E 46.8'
- #1- 36" Maple S82E 32.3'

B. Description of corner evidence found and/or method applied in restoring or reestablishing corner:

I found a 1" Sq. Shaft and both accessories from the old Township book. The shaft is S81W, 4.19' from the true intersection of the 1/4 lines. I accepted the shaft as found.

Condition of the accessories are as follows: #1 Found in good condition, #2 Found in good condition, #3 Found in good condition, #4 Found in good condition, #5 Found in good condition, #6 Found in good condition and #7 Found in good condition

C. Description of monument for corner and accessories established to perpetuate locating the position of the corner:


I replaced the shaft with an Osceola County Monument (1 1/2" pipe with Osceola County Remon Cap) as a substantial marker for the corner. This position not established by original government surveyors. This monument is accepted as the best available evidence of the position of the original corner.

- 24" Maple (Nail in S side) S50E 46.75' #7
- Steel mailbox Post (center) S30W 31.8'
- 36" Maple (Nail in N. side) S82E 31.8' #1
- 36" Maple (Nail in SE side) N16W 58.52' #2

APPROVED LAND CORNER
P.A. 345 OF 1990
Osceola County

10-21-99

R L W.

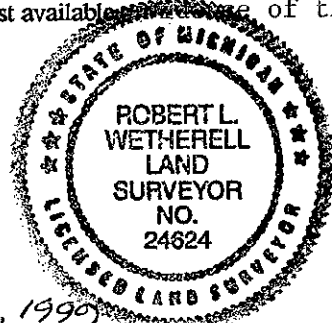

Signed by Robert L. Wetherell
Surveyor's Michigan License No. 24624

Date NOV. 9, 1999