

**SURVEY & REMONUMENTATION**

**LAND CORNER RECORDATION CERTIFICATE**

DEC 13 2000

FILING REQUIREMENT OF ACT 74, Mich. P.A. 1970

For Corner in SECTION  
Osceola

Located in: Corner Code#

- 1. Public Land Survey T 18 N R 8 W H-9  
T R  
T R  
T R
- 2. Property Controlling S T R  
in Section S T R
- 3. Miscellaneous S T R  
Property in Sec. S T R
- 4. Lot No.        Recorded Plat
- 5. Private Claims

OSCEOLA COUNTY REGISTER OF DEEDS  
 00 OCT 11 AM 9:49  
 Register of Deeds Stamp & File Number

I, Robert L. Wetherell, in a field survey on April 21, 2000, do hereby certify that under requirements of P.A. 74, Michigan P.A. of 1970, the corner points mentioned in lines 1 and 2 above were in conformance with regulations and rules therefore as required in the current manual of survey instructions of the United States Department of the Interior, Bureau of Land Management or by decree of a Court of Law and/or that the corner points mentioned in lines 3, 4, and 5 above were in conformance with the rules of the Michigan Board of Land Surveyors or by a Decree Of a Court of Law; established, re-established, monumented, re-monumented, recovered, found as expressed below:

|    | A  | B  | C  | D  | E  | F  | G | H | I | J | K | L | M |
|----|----|----|----|----|----|----|---|---|---|---|---|---|---|
| 1  |    |    |    |    |    |    |   |   |   |   |   |   |   |
| 2  | 6  | 5  | 4  | 3  | 2  | 1  |   |   |   |   |   |   |   |
| 3  |    |    |    |    |    |    |   |   |   |   |   |   |   |
| 4  | 7  | 8  | 9  | 10 | 11 | 12 |   |   |   |   |   |   |   |
| 5  |    |    |    |    |    |    |   |   |   |   |   |   |   |
| 6  | 18 | 17 | 16 | 15 | 14 | 13 |   |   |   |   |   |   |   |
| 7  |    |    |    |    |    |    |   |   |   |   |   |   |   |
| 8  | 19 | 20 | 21 | 22 | 23 | 24 |   |   |   |   |   |   |   |
| 9  |    |    |    |    |    |    |   |   |   |   |   |   |   |
| 10 | 30 | 29 | 28 | 27 | 26 | 25 |   |   |   |   |   |   |   |
| 11 |    |    |    |    |    |    |   |   |   |   |   |   |   |
| 12 | 31 | 32 | 33 | 34 | 35 | 36 |   |   |   |   |   |   |   |
| 13 |    |    |    |    |    |    |   |   |   |   |   |   |   |

**H-9 - 1/4 Corner common to Sections 22 & 27, T18N, R8W**

**A. Description of original monument and accessories and/or subsequent restoration:**

**1848 - O. Lyon, G.L.O.**

- #1 - 12" Bocch N55°W 44 Links
- #2 - 18" Hemlock S61 1/2°E 17 Links

**1894-1904 - Temple/Trumbull/June**

- Remonumented T18N, R8W with
- 3" Clay tiles with cinders.

**1975 M. McClung, LS 13037**

- L.C.R.C. - Liber 01, Pg. 352
- "Tile lost in road cut, set
- Brass cap in North & South fences.

- #3 - 18" Beech N28°W 32.00'
- #4 - 16" Beech N18°E 36.5'

**1986 - R.L. Wetherell, LS 24624**

- Unrecorded survey map File No. 138-86
- #5 - Capped Iron 500' West & 33' South.

**1993 - M. McClung, LS 13037**

- Found brass cap.
- #3 - 18" Beech N28°W 32.00'
- #4 - 16" Beech N18°E 36.5'
- #6 - 8" W. Ash S50°W 30.35'
- #7 - 18" Beech S10°W 38.2'

**B. Description of corner evidence found and/or method applied in restoring of reestablishing corner:**

I found a 1" pipe with an Osceola County Brass Cap in line with old fences North and South and in centerline of East and West seasonal road. There appears to be about a 7-foot road cut at this location. Besides the "74's" listed above, there was another recorded in Liber 02, Page 325 by J. Taylor, LS 32342, which is for H-9 of T18N, R10W.


Condition of the accessories are as follows: #1 Gone, #2 Gone, #3 Found in good condition, #4 Found in good condition, #5 Found in good condition, #6 Found Stump, #7 Found Stump.

**C. Description of monument for corner and accessories established to perpetuate locating the position of the corner:**

I accepted the 1" pipe with Osceola County Brass Cap, as a substantial marker for the corner, and is accepted as a careful and faithful reestablishment of the position of the original corner.

- 20" Beech N26°W 32.28' (60d spike S.W. side) #3
- 13" Beech N50°E 41.17' (60d spike S.E. side)
- 10" Beech S58°W 48.08' (60d spike N.W. side)
- 7" Twin Maple S45°E 41.73' (60d spike S.W. side)

APPROVED LAND CORNER  
 P.A. 345 OF 1990  
 Osceola County  
R.L.W.  
8-17-2000

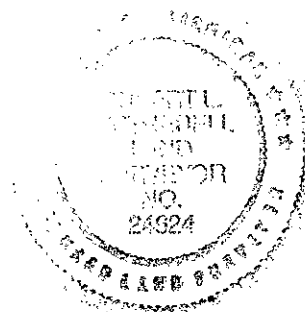

Signed by Robert L. Wetherell  
 Surveyor's Michigan License No. 24624

Date August 22, 2000

FORM APPROVED BY MICHIGAN STATE BOARD OF LAND SURVEYORS, JAN. 28, 1971  
 REVISED MAY 14, 1975  
 REVISED JAN. 1983  
 ADAPTED FOR WORD PROCESSING JANUARY, 1999