

NOV 01 1999

SECTION

LAND CORNER RECORDATION CERTIFICATE
Filing Requirement of Act 74, Mich. P.A. 1970

For corners in

Osceola Located In: Corner Code #
1. Public Land Survey T18N R8W I-4
2. Property Controlling in Section S T R
3. Miscellaneous Property in Sec. S T R

Register of Deeds Stamp & File Number

4. Lot No. Recorded Plat
5. Private Claims

Robert L. Wetherell in a field survey on Aug 11 1999 do hereby state that under requirements of P.A. 74, Michigan P.A. of 1970, the corner points mentioned in lines 1 and 2 above were in conformance with regulations and rules therefore as required in the current manual of survey instructions of the United States Department of the Interior, Bureau of Land Management or by a decree of a Court of Law and /or that the corner points mentioned in lines 3, 4 and 5 above were in conformance with the rules of the Michigan Board of Land Surveyors or by a Decree of a Court of Law; established, re-established, monumented, recovered, found as expressed below:

NOTE: Not more than 2 corners, all in the same town and range, may be recorded on this certificate.

I-4 - E 1/4 Corner of Section 10, T18N, R8W

Grid table with columns A-M and rows 1-13. A dot is marked at the intersection of row 4 and column I.

A. Description of original monument and accessories and/or subsequent restoration:

1848 - O. Lyon
#1-9" Beech S44E 35 Lks.
#2-18" Beech N44W 9 Lks

1891 - 1904 - A. Temple/F. Trumbull
Remonumentation of T18N, R8W
Set 3" Clay tiles

Undated Osceola Twp Book
Pages 12 & 13
#3-S 1/2 East Line = 2624.16'

(SEE OVER FOR CONTINUATION OF "A")

B. Description of corner evidence found and/or method applied in restoring or reestablishing corner:


I set the corner according to M. McClung's computed position from 1996. Corner falls in line with Fence to East and in C/L of North and South Road. The road has been cut approximately 6 feet at this location, which would have destroyed the clay tile.

Condition of the accessories are as follows: #1 Gone, #2 Gone and #3 Measured 2621.045' on the S 1/2 East line of section 10.

C. Description of monument for corner and accessories established to perpetuate locating the position of the corner:

I accept the Osceola County Monument (1 1/2" Pipe with Osceola County Remon Cap) as a substantial marker for the corner and is accepted as a careful and faithful reestablishment of the position of the original corner.

Power Pole (Nail in E. side) N10W 179.17'
Power Pole (Nail in E. side) S54W 65.62'
Power Pole (Nail in E side) S16W 328.89'
14" Elm (Nail in S. side) N88E 75.72'

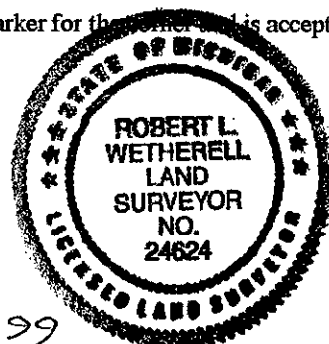

Signed by Robert L. Wetherell
Surveyor's Michigan License No. 24624
APPROVED LAND CORNER
P.A. 345 OF 1990
Osceola County

Date 8-26-99

8-26-99
RLW

OSCEOLA COUNTY
REGISTER OF DEEDS

99 SEP -3 AM 11:48

Nancy Crawford

CONTINUATION OF DESCRIPTION OF ORIGINAL MONUMENT AND ACCESSORIES AND/OR SUBSEQUENT RETORATION.

1996 -- McClung LS 13037
Computed Position, in F. Line East
And C/L North & South Road
(Nothing set)

SURVEY &
REMONUMENTATION

NOV 01 1999

SECTION