

DEC 13 2000

SECTION

LAND CORNER RECORDATION CERTIFICATE

FILING REQUIREMENT OF ACT 74, Mich. P.A. 1970

For corners in Osceola Located in: Corner Code#


1. Public Land Survey T 18 N R 8 W I-9
 T R
 T R
 T R

2. Property Controlling in Section S T R
 S T R

3. Miscellaneous Property in Sec. S T R
 S T R

4. Lot No. _____ Recorded Plat _____

5. Private Claims _____

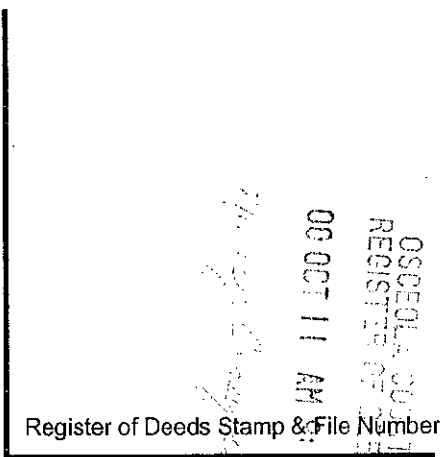

I, Robert L. Wetherell, in a field survey on April 21, 2000, do hereby certify that under requirements of P.A. 74, Michigan P.A. of 1970, the corner points mentioned in lines 1 and 2 above were in conformance with regulations and rules therefore as required in the current manual of survey instructions of the United States Department of the Interior, Bureau of Land Management or by decree of a Court of Law and/or that the corner points mentioned in lines 3, 4, and 5 above were in conformance with the rules of the Michigan Board of Land Surveyors or by a Decree of a Court of Law; established, re-established, monumented, re-monumented, recovered, found as expressed below:

	A	B	C	D	E	F	G	H	I	J	K	L	M
1													
2	6	5	4	3	2	1							
3													
4	7	8	9	10	11	12							
5													
6	18	17	16	15	14	13							
7													
8	19	20	21	22	23	24							
9													
10	30	29	28	27	26	25							
11													
12	31	32	33	34	35	36							
13													

I-9 - Section corner common to Sections 22, 23, 26 & 27, T18N, R8W

A. Description of original monument and accessories and/or subsequent restoration:

1848 - O. Lyon, G.L.O.
 #1 - 10" Sugar S73°E 16 Links
 #2 - 24" Hemlock S18°W 22 Links

1894 - 1904 - Temple/Trumbull/June
 Remonumented T18N, R8W with
 3" Clay Tiles with Cinders.

Undated from Co. Sur. Twp. Notes
 Page 34.
 #3 - Distance East = 2599.74'

1987 - M. McClung, LS 13037
 Survey recorded in Liber 494, Pg. 602.
 "Set 5/8" steel rod with cap in blacktop"
 record distance from the N. ¼ Sec. 26 and
 in centerline of road to West.

1993 - M. McClung, LS 13037
 L.C.R.C. - Liber 03, Pg. 71
 5/8" Capped Iron
 #4 - Stop sign S75°W 55.4'
 #5 - Tel. Ped. S50°E 37.9'
 #6 - Stop sign N80°E 41.0'
 #7 - P. Pole N70°W 75.3'

1997 - D. Geers, LS 33977
 L.C.R.C. - Liber 03, Pg. 134
 Found Capped Iron. Set iron and
 cap (LS 14102) in monument box.
 #8 - 102 mm B. Ash N60°E 14.853 m
 #7 - P. Pole N65°W 22.950 m
 #9 - Wit. Iron S35°E 21.101 m
 #10 - Wit. Iron S80°E 12.855 m

B. Description of corner evidence found and/or method applied in restoring of reestablishing corner:

I found a ½" Capped Iron (marked LS 14102) in monument box, 3 feet East of centerline of North and South road and in centerline of seasonal road East and West. I measured 2630.37 feet South to the 1/4 corner.

Condition of the accessories are as follows: #1 Gone, #2 Gone, #3 Measured 2604.77', #4 Found in good condition, #5 Found in good condition, #6 Found in good condition, #7 Found in good condition, #8 Found in good condition, #9 Found ½" Iron, #10 Found ½" Iron.

C. Description of monument for corner and accessories established to perpetuate locating the position of the corner:

I accepted the ½" Capped Iron in the monument box as a substantial marker for the corner, and is accepted as a careful and faithful reestablishment of the position of the original corner.

P. Pole N66°W 74.27' (P.K. S. side) #7
 6" Cedar S73°W 97.42' (60d spike N. side)
 11" Cherry S70°E 108.04' (60d spike S. side)
 6" Maple N83°E 121.99' (60d spike S. side)

APPROVED LAND CORNER
 P.A. 345 OF 1990
 Osceola County

R.L.W.
8-17-2000



Signed by Robert L. Wetherell

Date August 22, 2000

Surveyor's Michigan License No. 24624