

**SURVEY &  
REMONUMENTATION**

AUG 23 1995

**COMMISSION**

**LAND CORNER RECORDATION CERTIFICATE  
Filing Requirement of Act 74, Mich. P.A. 1970**

For corners in

Osceola  
(County)

Located In:

Corner Code #

		18N	8W	M-11
1. Public Land Survey	T	_____	R	_____
	T	_____	R	_____
	T	_____	R	_____
	T	_____	R	_____
2. Property Controlling in Section	S	_____	T	_____
	S	_____	T	_____
3. Miscellaneous Property in Sec.	S	_____	T	_____
	S	_____	T	_____

**APPROVED LAND CORNER  
P.A. 345 OF 1990  
Osceola County**

*Matthew McClung*  
August 3, 1995

**Register of Deeds Stamp & File Number**

4. Lot No. \_\_\_\_\_, Recorded Plat \_\_\_\_\_  
5. Private Claims \_\_\_\_\_

Matthew McClung July 20, 1995

I, \_\_\_\_\_, in a field survey on \_\_\_\_\_, 19\_\_\_\_, do hereby certify that under requirements of P.A. 74, Michigan P.A. of 1970, the corner points mentioned in lines 1 and 2 above were in conformance with regulations and rules therefore as required in the current manual of survey instructions of the United States Department of the Interior, Bureau of Land Management or by a decree of a Court of Law and/or that the corner points mentioned in lines 3, 4 and 5 above were in conformance with the rules of the Michigan Board of Land Surveyors or by a Decree of a Court of Law; established, re-established, monumented, re-monumented, recovered, found as expressed below:

**NOTE: Not more than 4 corners, all in the same town and range, may be recorded on this certificate.**

A	B	C	D	E	F	G	H	I	J	K	L	M
2	6	5	4	3	2	1						
3												
4	7	8	9	10	11	12						
5												
6	18	17	16	15	14	13						
7												
8	19	20	21	22	23	24						
9												
10	30	29	28	27	26	25						
11												
12	31	32	33	34	35	36						
13												


A. Description of original monument and accessories and/or subsequent restoration:

The original corner was set by deputy surveyor John Hodgson on Dec. 9, 1937. Set temp. wood post 80.00 chains from the South Final Corner set Sugar 10" S20W 29 Lks. 2.07 chains North of temp post. Sugar 10" N66E 42 Lks.

From 1891 to 1904 approximately, Osceola County had a remonumentation program, in which surveyors Temple and Trumbull, did the work. For the most part, a 3" glazed tile filled with cinders from a forge, were placed at each government set corner in the township. There were supposed to be 3 tile per corner, placed atop of each other, (continued on back)

B. Description of corner evidence found and/or method applied in restoring or reestablishing corner:

Found Osceola County Monument 3" below road surface. Found Tile around Monument at 12" below surface. Placed Osceola Monument 6" below surface.

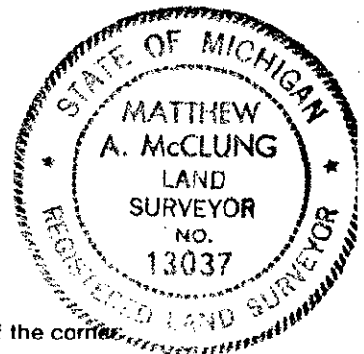

C. Description of monument for corner and accessories established to perpetuate localing the position of the corner:

Corner M-11. Osceola County Monument, which is a 3" brass cap mounted on a 1" pipe 18" in length.

- 24" Maple S60E 55.12 feet O.B.T.
- 25" Maple N80E 69.02 feet. O.B.T.
- 10" Cherry S26W 60.90 feet.
- 22" Maple S39E 63.00 feet.

Signed by *Matthew McClung* Date July 20, 1993  
Surveyor's Michigan License No. 13037

FORM APPROVED BY MICHIGAN STATE BOARD OF LAND SURVEYORS, JAN. 28, 1971  
REVISED MAY 14, 1975  
REVISED JAN., 1983

thereby making the corner 4 feet long. Sometimes a solid tile, with a cross in the top was used, and sometimes a 1/2" iron bars were added to the tile. Notes of the work were kept in ledgers, and given to the townships, and 5 of the townships have been recorded in the County records.

I have shown 2 132 PA survey certificates. One by Wetherell and one by Knapp.

I have shown 1 LCRC certificate by Lapham.

OSCEOLA COUNTY  
REGISTER OF DEEDS  
95 AUG -9 PM 12: 13  
*Yancy Crawford*