

LAND CORNER RECORDATION CERTIFICATE

FILING REQUIREMENT OF ACT 74, MICH. P.A.1970

FOR CORNERS OF--:	LOCATED IN--:	CORNER CODE NUMBER
1. PUBLIC LAND SURVEY _____	T. 18 N. R. 9 W.	K-9; M-13
2. PROPERTY CONTROLLING IN SECTION _____	25, T. 18 N. R. 9 W.	3
3. MISCELLANEOUS PROPERTY IN SECTION _____	T. _____ N. S., R. _____ E. W.	
4. LOT NO. _____, RECORDED PLAT _____		
5. PRIVATE CLAIMS _____		

REGISTER OF DEEDS STAMP AND FILING NUMBER

I, Kenneth J. Ostling, do hereby certify that under requirements of P.A. 74, Michigan P.A. of 1970, the corner points mentioned in lines 1 and 2 above were, in a field survey on August 23, 1977, established, re-established, monumented, re-monumented, recovered or restored as expressed below and in conformance with regulations and rules therefore as required in the current manual of survey instructions of the United States Department of the Interior, Bureau of Land Management or by a decree of a court of law. Furthermore, that the corner points mentioned in lines 3, 4 and 5 above were, in a field survey on _____, 19____, found, recovered, restored, established or re-established as expressed below and in conformance with the rules of the Michigan State Board of Registration for Land Surveyors or, by a Decree of a Court of law:

~~A. Description of original monument or other evidence established to perpetuate locating the position of the corner:~~

B. Description of corner evidence found and/or method applied in restoring or re-establishing corner:
 1-9 Set corner from F. McClung NBT stumps, which falls in line with section and W 1/8 corner east and section and N 1/8 corner south.

1-13 Found iron-tile monument at township corner; previously restored by Temple in townline survey.


3 Corner set by Lake State Survey & Engineering during subdivision of Sec. 26, by standard survey procedure. Falls in remains of old fence lines E-W-S.

C. Description of monument for corner and accessories established to perpetuate locating the position of the corner:

K-9	M-13	3
Set DNR mon. & cedar post	Set DNR mon. & cedar post	Left 1/2" rod w/RLS cap #17615 in place, added cedar post
18" S. Maple N30°W 74.2	at iron-tile monument	8" Beech S35°E 62.9
24" W.Pine Stp.S70°E 65.3	9" Maple N70°W 11.1	3" R. Oak S72°W 47.3
14" W.Pine Stp.N35°E 25.3	3" R. Oak N70°E 11.8	
*14" W.Pine Stp.N22°E 26.4	7" Maple S10°E 30.5	
*McClung NBT	Old E-W fence Due N 33'	

SIGNED BY *Kenneth J. Ostling* DATE 12

SURVEYOR'S MICHIGAN REGISTRATION NO. 10068

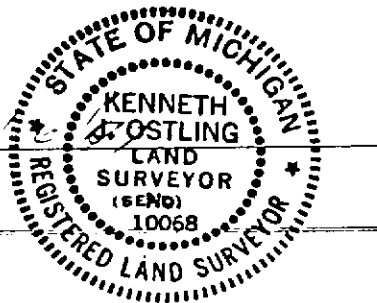

FOR STATE AND UNITED STATES AGENCIES:

SIGNED BY _____ DATE _____
CHIEF OF SURVEY PARTY

APPROVED AND SIGNED BY _____ DATE _____
MICHIGAN REGISTERED LAND SURVEYOR (SEAL)

SURVEYOR'S MICHIGAN REGISTRATION NO. _____

CEDAR TOWNSHIP
OSCEOLA COUNTY