

# LAND CORNER RECORDATION CERTIFICATE

FILING REQUIREMENT OF ACT 74, MICH. P.A.1970

FOR CORNERS OF--:	LOCATED IN--:	CORNER CODE NUMBER
1. PUBLIC LAND SURVEY	T. 18 N. R. 9 W.	G-9;H-9;H-11;I-10
2. PROPERTY CONTROLLING IN SECTION	T. _____ N. S. R. _____ E. W.	_____
3. MISCELLANEOUS PROPERTY IN SECTION	T. _____ N. S. R. _____ E. W.	_____
4. LOT NO. _____, RECORDED PLAT _____		
5. PRIVATE CLAIMS _____		

REGISTER OF DEEDS STAMP AND FILING NUMBER

I, Kenneth J. Ostling, do hereby certify that under requirements of P.A. 74, Michigan P.A. of 1970, the corner points mentioned in lines 1 and 2 above were, in a field survey on September 1, 1977, established, re-established, monumented, re-monumented, recovered or restored as expressed below and in conformance with regulations and rules therefore as required in the current manual of survey instructions of the United States Department of the Interior, Bureau of Land Management or by a decree of a court of law. Furthermore, that the corner points mentioned in lines 3, 4 and 5 above were, in a field survey on \_\_\_\_\_, 19\_\_\_\_, found, recovered, restored, established or re-established as expressed below and in conformance with the rules of the Michigan State Board of Registration for Land Surveyors or, by a Decree of a Court of law:

A. ~~Description of original monument and accessories and/or subsequent restoration:~~  
 C. (Continued)

I-10  
 Set DNR mon. & cedar post  
 7" Maple in clump of 5  
                                     N10°W   11.8  
 3" R. Oak                   S75°E   16.2  
 6" R. Oak                   S30°W   37.1

B. Description of corner evidence found and/or method applied in restoring or re-establishing corner:  
 3-9 Found well point at corner in centerline of E-W road, and in line with fence north. Used by McClung in local survey.

1-9 Found plow point at corner as previously located by McClung in local survey, 3' north of road centerline.


1-11 Found plow point in line with fence line north. Probably F. McClung corner from local survey.

10 Set corner by proportionate measurement between section corners. This position used by Lake State Surveys in subdivision of Sec. 26. No previous corner.

C. Description of monument for corner and accessories established to perpetuate locating the position of the corner:

G-9	H-9	H-11
Left well point in place	Fd. plow point, added 5/8x40" Rod w/RLS Cap	Fd. plow point, added 5/8x40" iron bar w/cap
6" Cherry           S52°E   86.0	18" Apple       N65°W   126.6	4" S. Maple     S35°E   35.2
21" R. Oak       Due W   61.8	8" Maple in clump of 4	6" S. Maple     S30°W   43.7
Set cedar post w/loc. tag	S55°W   110.8	Set cedar post w/loc. tag
Due N   33	Set cedar post w/loc. tag	Due N   33
	Due N   33	

SIGNED BY *Kenneth J. Ostling* DATE \_\_\_\_\_  
 SURVEYOR'S MICHIGAN REGISTRATION NO. 10068

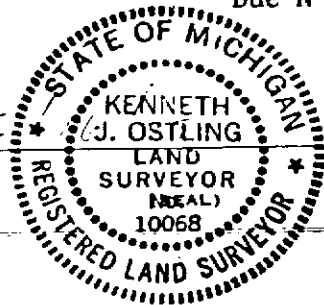

FOR STATE AND UNITED STATES AGENCIES:

SIGNED BY \_\_\_\_\_ DATE \_\_\_\_\_  
CHIEF OF SURVEY PARTY  
 APPROVED AND SIGNED BY \_\_\_\_\_ DATE \_\_\_\_\_  
MICHIGAN REGISTERED LAND SURVEYOR (SEAL)

SURVEYOR'S MICHIGAN REGISTRATION NO. \_\_\_\_\_ CEDAR TOWNSHIP OSCEOLA COUNTY

MAY PLACE SKETCH ON BACK OR ATTACHED SHEET