

LAND CORNER RECORDATION CERTIFICATE

FILING REQUIREMENT OF ACT 74, MICH. P.A. 1970

FOR CORNERS OF--: 1. PUBLIC LAND SURVEY _____ 2. PROPERTY CONTROLLING IN SECTION _____ 3. MISCELLANEOUS PROPERTY IN SECTION _____ 4. LOT NO. _____, RECORDED PLAT _____ 5. PRIVATE CLAIMS _____	LOCATED IN--: T. <u>18</u> N. R. <u>9</u> W. T. <u>18</u> N. R. <u>9</u> W. T. _____ N. R. _____ E. W.	CORNER CODE NUMBER M-8; M-9; M-10 14
---	--	---

REGISTER OF DEEDS STAMP AND FILING NUMBER

I, Kenneth J. Ostling, do hereby certify that under requirements of P.A. 74, Michigan P.A. of 1970, the corner points mentioned in lines 1 and 2 above were, in a field survey on August 17, 1977, established, re-established, monumented, re-monumented, recovered or restored as expressed below and in conformance with regulations and rules therefore as required in the current manual of survey instructions of the United States Department of the Interior, Bureau of Land Management or by a decree of a court of law. Furthermore, that the corner points mentioned in lines 3, 4 and 5 above were, in a field survey on _____, 19____, found, recovered, restored, established or re-established as expressed below and in conformance with the rules of the Michigan State Board of Registration for Land Surveyors or, by a Decree of a Court of law:


C. (continued)

14
 Set 5/8"x40" rod w/RLS cap and cedar post
 7" Sugar Maple N33°W 22.2
 3" R. Maple S60°E 19.4

- B. Description of corner evidence found and/or method applied in restoring or re-establishing corner:
- 4-8 Found iron-tile mon. faced by one Temple B.T. stump. Falls in N-S fence line.
 - 4-9 Fd. iron-tile mon. at fence corner N-S-E. Probably set by Temple in a local survey of township line.
 - 10 Fd. iron-tile mon. at corner in N-S fence line, with one U.S.B.T. stump remains in place.
 - 14 Set by standard survey procedure for subdivision of sections. Falls in remains of old N-S fence line.

- C. Description of monument for corner and accessories established to perpetuate locating the position of the corner:
- | | | |
|---|---|--|
| M-8
Fd. 1/2" rod in 3 tiles, added DNR monument and cedar post
5" Maple N10°W 9.8
5" R. Oak S50°E 16.9
5" R. Oak S72°W 15.5
1d 30" Pine Stump N55°E 20.5 | M-9
Set DNR mon. & cedar post at fd. 1/2" iron rod in tile mon.
10" Maple N20°W 40.7
13" Maple N15°E 18.2
8" Maple S62°W 24.2 | M-10
Set DNR mon. & cedar post at iron-tile monument
8" Maple N25°E 6.9
8" Maple N80°E 4.2
12" R. Oak S35°W 50.3
N-S random Due W 2.5 |
|---|---|--|

SIGNED BY Kenneth J. Ostling DATE 12/1

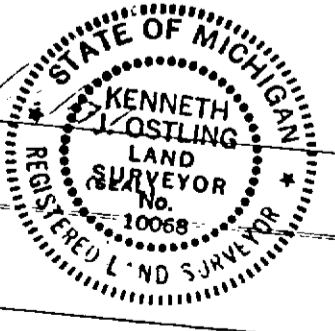

SURVEYOR'S MICHIGAN REGISTRATION NO. 10068

FOR STATE AND UNITED STATES AGENCIES:
 SIGNED BY _____ CHIEF OF SURVEY PARTY DATE _____
 APPROVED AND SIGNED BY _____ MICHIGAN REGISTERED LAND SURVEYOR DATE _____

SURVEYOR'S MICHIGAN REGISTRATION NO. _____

CEDAR TOWNSHIP
OSCEOLA COUNTY

MAY PLACE SKETCH ON BACK OR ATTACHED SHEET