

**SURVEY &
REMONUMENTATION**

DEC 13 2000

LAND CORNER RECORDATION CERTIFICATE

FILING REQUIREMENT OF ACT 74, Mich. P.A. 1970

SECTION

For corners in Osceola	Located in:	Corner Code#
1. Public Land Survey	T 18 N R 9 W	C-10
	T R	
	T R	
	T R	
2. Property Controlling in Section	S T R	
	S T R	
3. Miscellaneous Property in Sec.	S T R	
	S T R	
4. Lot No. _____ Recorded Plat _____		
5. Private Claims _____		

OSCEOLA COUNTY
 REGISTER OF DEEDS
 00 OCT 11 AM 9:49
 Register of Deeds Stamp & File Number

	A	B	C	D	E	F	G	H	I	J	K	L	M
1													
2	6	5	4	3	2	1							
3													
4	7	8	9	10	11	12							
5													
6	18	17	16	15	14	13							
7													
8	19	20	21	22	23	24							
9													
10	30	29	28	27	26	25							
11													
12	31	32	33	34	35	36							
13													

I, Robert L. Wetherell, in a field survey on **May 8 2000**, do hereby certify that under requirements of P.A. 74, Michigan P.A. of 1970, the corner points mentioned in lines 1 and 2 above were in conformance with regulations and rules therefore as required in the current manual of survey instructions of the United States Department of the Interior, Bureau of Land Management or by decree of a Court of Law and/or that the corner points mentioned in lines 3, 4, and 5 above were in conformance with the rules of the Michigan Board of Land Surveyors or by a Decree Of a Court of Law; established, re-established, monumented, re-monumented, recovered, found as expressed below:

C-10 - 1/4 Corner common to Sections 29 & 30, T18N, R9W

A. Description of original monument and accessories and/or subsequent restoration:

1838 - J. Hodgson, G.L.O.
 #1 - 7" Beech N39°W 48 Links
 #2 - 10" Pine S23°E 18 Links

Undated - Co. Sur. Twp. Notes
 Page 6
 #3 - Stump N66°E 28.7'
 #4 - Stump N20°E 65.7'

1978 - R.L. Wetherell, LS 24624
 L.C.R.C. Liber 02, Pg. 58.
 "Set 1" Pipe in centerline of road and in line with fences East and West, position fits good with occupation at 1/16 lines".
 #5 - P. Pole N82°W 73.59'
 #6 - 8" R. Pine S14°W 132.30'
 #7 - 5" R. Pine N56°E 54.97'

B. Description of corner evidence found and/or method applied in restoring of reestablishing corner:

I did not find the 1" pipe I set in 1978 (road construction destroyed corner). I reset the corner from recovered accessories #5, #6 & #7 above. Corner is in centerline of road North and South and in line with old stump fence East and West. I measured 2646.55 feet North to Section corner and 2615.58 feet South to Section corner.

Condition of the accessories are as follows: #1 Gone, #2 Gone, #3 Gone, #4 Gone, #5 Found in good condition, #6 Found in good condition, #7 Found in good condition.


C. Description of monument for corner and accessories established to perpetuate locating the position of the corner:

I set a 1" x 18" Pipe with Osceola County Remon Cap, and is accepted as a careful and faithful reestablishment of the position of the original corner.

- 12" W. Pine S30°E 157.17' (60d spike E. side)
- 16" W. Oak S56°W 131.93' (60d spike S.E. side)
- 8" Cherry N87°W 48.36' (60d spike S. side)
- P. Pole N82°W 73.59' (60d spike N. side) #5
- 10" R. Pine N56°E 54.97' (60d spike S.E. side) #7

APPROVED LAND CORNER
 P.A. 345 OF 1990
 Osceola County

R. L. W.
8-17-2000

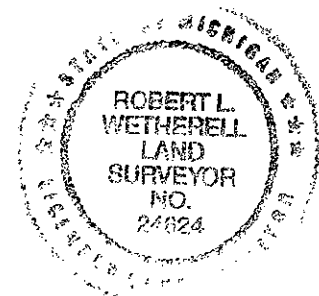

Signed by Robert L. Wetherell
 Surveyor's Michigan License No. 24624

Date August 22, 2000

FORM APPROVED BY MICHIGAN STATE BOARD OF LAND SURVEYORS, JAN. 28, 1971
 REVISED MAY 14, 1975
 REVISED JAN. 1983
 ADAPTED FOR WORD PROCESSING JANUARY, 1999