

**SURVEY & REMONUMENTATION**

FEB 12 1998

**SECTION**

**LAND CORNER RECORDATION CERTIFICATE**  
Filing Requirement of Act 74, Mich. P.A. 1970

For corners in

Osceola  
(County)

Located In:

Corner Code #

- |                                    |                         |             |
|------------------------------------|-------------------------|-------------|
| 1. Public Land Survey              | T <u>18</u> R <u>9W</u> | <u>C-13</u> |
|                                    | T ___ R ___             | _____       |
|                                    | T ___ R ___             | _____       |
|                                    | T ___ R ___             | _____       |
| 2. Property Controlling in Section | S ___ T ___ R ___       | _____       |
|                                    | S ___ T ___ R ___       | _____       |
| 3. Miscellaneous Property in Sec.  | S ___ T ___ R ___       | _____       |
|                                    | S ___ T ___ R ___       | _____       |

APPROVED LAND CORNER  
P.A. 345 OF 1990  
Osceola County

*16 Oct 1997*  
*Matthew McClung*

Register of Deeds Stamp & File Number

4. Lot No. \_\_\_\_\_, Recorded Plat \_\_\_\_\_  
5. Private Claims \_\_\_\_\_

I, Matthew McClung, in a field survey on Oct. 7 19 97 do hereby state that under requirements of P.A. 74, Michigan P.A. of 1970, the corner points mentioned in lines 1 and 2 above were in conformance with regulations and rules therefore as required in the current manual of survey instructions of the United States Department of the Interior, Bureau of Land Management or by a decree of a Court of Law and /or that the corner points mentioned in lines 3, 4 and 5 above were in conformance with the rules of the Michigan Board of Land Surveyors or by a Decree of a Court of Law; established, re-established, monumented, recovered, found as expressed below:

NOTE: Not more than 2 corners, all in the same town and range, may be recorded on this certificate.

	A	B	C	D	E	F	G	H	I	J	K	L	M
1													
2	6		5		4		3		2		1		
3													
4	7		8		9		10		11		12		
5													
6	18		17		16		15		14		13		
7													
8	19		20		21		22		23		24		
9													
10	30		29		28		27		26		25		
11													
12	31		32		33		34		35		36		
13													

A. Description of original monument and accessories and/or subsequent restoration:

The original corner was set by deputy surveyor John Hodgson on 21 November 1837. Set wood post 80.00 chains from East.

Maple 10" N56E 18 lks.

Maple 10" N17W 23 lks.

Cedar Township Book Pages 48 & 49. ( I believe this recording to be in Corner 4 Shows tile & rod. error, as this fits C-1 T17N-R9W)  
Oak SE 41.5 feet. Pine Stump S. 3 feet., (continued on back)

B. Description of corner evidence found and/or method applied in restoring or reestablishing corner:

I found the above tile, rod & Pine stump in above witness. I measured west 52.8 feet to find location for this corner. Found old 24" pine Stump with 3 blazes S26W 17.0 feet. I placed the corner 52.8 feet west of Hersey corner, in fence line to west. The surveys shown in above Cedar Twp. Book, go North from the Hersey Corner, not the Cedar Corner.

C. Description of monument for corner and accessories established to perpetuate locating the position of the corner:

Corner C-13. Osceola County Monument, which is a 3" brass cap mounted on a 1" pipe 30" in length.

Old pine Stump with 3 blazes S26W 17.0 feet.

Osceola County Monument East 52.8 feet.

18" R. Oak w/nail N70E 28.25 feet..


18" R. Oak N44E 18.3 feet.

14" R. Oak N48W 29.6 feet.

18" North most Beech in Clump S42E 34.5 feet.

Signed by Matthew McClung  
Surveyor's Michigan License No. 13037

Date Sept. 21, 1996

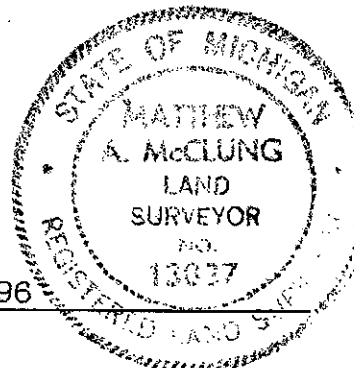

OSCEOLA COUNTY  
REGISTER OF DEEDS

97 NOV 26 AM 11:48

*Nancy Crawford*

P.A. 132 by Nordland, Liber 388, page 99  
Dated May 10, 1977  
5" Maple S30W 112.20 feet.  
Twin Maple S80E 46.28 feet.

P.A. 132 Liber 483, page 503.  
By Richard Hayes.  
No Witnesses given.

**SURVEY &  
REMONUMENTATION**

**FEB 12 1998**

**SECTION**