

**SURVEY & REMONUMENTATION**

**FEB 12 1998**

**LAND CORNER RECORDATION CERTIFICATE**  
Filing Requirement of Act 74, Mich. P.A. 1970

For corners in **SECTION**

Osceola Located In: \_\_\_\_\_ Corner Code # \_\_\_\_\_  
(County)

1. Public Land Survey T 18N 9W D-13  
T \_\_\_\_\_ R \_\_\_\_\_  
T \_\_\_\_\_ R \_\_\_\_\_  
T \_\_\_\_\_ R \_\_\_\_\_

2. Property Controlling S \_\_\_\_\_ T \_\_\_\_\_ R \_\_\_\_\_  
in Section S \_\_\_\_\_ T \_\_\_\_\_ R \_\_\_\_\_

3. Miscellaneous S \_\_\_\_\_ T \_\_\_\_\_ R \_\_\_\_\_  
Property in Sec. S \_\_\_\_\_ T \_\_\_\_\_ R \_\_\_\_\_

APPROVED LAND CORNER  
P.A. 345 OF 1990  
Osceola County  
*16 OCT. 1997*  
*Matthew McClung*

Register of Deeds Stamp & File Number

4. Lot No. \_\_\_\_\_, Recorded Plat \_\_\_\_\_  
5. Private Claims \_\_\_\_\_

Matthew McClung, in a field survey on Sept 12 1997 do hereby state that under requirements of P.A. 74, Michigan P.A. of 1970, the corner points mentioned in lines 1 and 2 above were in conformance with regulations and rules therefore as required in the current manual of survey instructions of the United States Department of the Interior, Bureau of Land Management or by a decree of a Court of Law and /or that the corner points mentioned in lines 3, 4 and 5 above were in conformance with the rules of the Michigan Board of Land Surveyors or by a Decree of a Court of Law; established, re-established, monumented, recovered, found as expressed below:


NOTE: Not more than 2 corners, all in the same town and range, may be recorded on this certificate.

	A	B	C	D	E	F	G	H	I	J	K	L	M
1													
2		6		5		4		3		2		1	
3													
4		7		8		9		10		11		12	
5													
6		13		17		16		15		14		13	
7													
8		19		20		21		22		23		24	
9													
10		30		29		28		27		26		25	
11													
12		31		32		33		34		35		36	
13													

A. Description of original monument and accessories and/or subsequent restoration:  
The original corner was set by deputy surveyor John Hodgson on 21 November 1837. Set wood post 40.00 chains from East.  
Beech 7" N76E 22 Lks.  
Pine 10" N28W 20 Lks  
Cedar Township Book, Page 5; 1/4 Corner 5 & 32 (Hersey and Cedar) Iron-Oak NE 39 feet.; Fence Post West 24.5 feet- Stone NW 37.5 feet.  
(continued on back)

B. Description of corner evidence found and/or method applied in restoring or reestablishing corner:  
Set Osceola County Monument 35.65 feet West from closing corner. The closing corner is tile with pump. I believe the surveyor that recorded the corner in Cedar Township Book was in error.

C. Description of monument for corner and accessories established to perpetuate locating the position of the corner:  
Corner D-13. Osceola County Monument, which is a 3" brass cap mounted on a 1" pipe 18" in length.  
36" W. Oak w/nail N82W 77.65 feet.  
Power Pole N08E 51.63 feet.  
Telephone Pedestal N56E 74.25 feet.  
6" R. Pine w/nail S50W 12.4 feet.

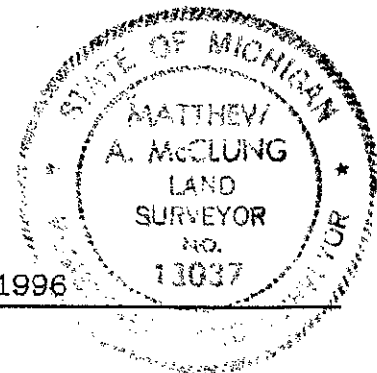

Signed by Matthew McClung  
Surveyor's Michigan License No. 13037

Date Sept. 21, 1996

OSCEOLA COUNTY  
REGISTER OF DEEDS

97 NOV 26 AM 11:47

*Nancy Crawford*

Hersey Township Book  
Front pages, Page 5  
1/4 Corner 5 & 32 (Hersey & Cedar)  
Iron  
Oak NE 39.0 feet  
Post West 24.5 feet  
Stone NW 37.5 feet

PA 132  
Liber 388, Page 828 Dated Sept  
25, 1991 by Wetherell  
No witnesses

**SURVEY &  
REMONUMENTATION**

**FEB 12 1998**

**SECTION**