

FEB 13 1999

LAND CORNER RECORDATION CERTIFICATE
Filing Requirement of Act 74, Mich. P.A. 1970

For corners in SECTION

Table with columns: Osceola (County), Located In: (Town, Range, Section), Corner Code #. Includes entries for Public Land Survey, Property Controlling in Section, and Miscellaneous Property in Sec.

APPROVED LAND CORNER
P.A. 345 OF 1990
Osceola County

Handwritten signature and date: Matthew M. Pugh, 6 Aug 1997

Register of Deeds Stamp & File Num

4. Lot No. , Recorded Plat

5. Private Claims

I, Craig W. McVean, in a field survey on June, 12 1997 do hereby state that under requirements of P.A. 74, Michigan P.A. of 1970, the corner points mentioned in lines 1 and 2 above were in conformance with regulations and rules therefore as required in the current manual of survey instructions of the United States Department of the Interior, Bureau of Land Management or by a decree of a Court of Law and /or that the corner points mentioned in lines 3, 4 and 5 above were in conformance with the rules of the Michigan Board of Land Surveyors or by a Decree of a Court of Law; established, re-established, monumented, recovered, found as expressed below:

Grid table with columns A-N and rows 1-13. A dot is marked at the intersection of column E and row 2.

NOTE: Not more than 2 corners, all in the same town and range, may be recorded on this certificate.

A. Description of original monument and accessories and/or subsequent restoration:

E-2 -GLO- Set 1/4 Post-J. Hodgson-1838
Beech 10" S38°E 30L., Beech 10" N88°W 20L.
-Osceola Co. Cedar FB., P.14-17 -1904, Partial Sub. of Sec. 4 & 5 . Pine 16" S54°E 57.75, Pine 18" S45°W 63.5
-Unrecorded LCRC -P. Case- 1988 - Set rered and LLS cap #30079 from both Osceola Co. Surveyor Pine Wit. Stps. Iron falls 1' SW of 4" dia. steel cor. fen. post at 4-way fence inter. - N12°W 6" Oak 23.23', S55°E 4" Maple 16.26', S45°W 14" W. Birch 86.15', N50°W 14" Oak in Clp. 65.03'

OSCEOLA COUNTY REGISTER OF DEEDS
98 DEC 17 PM 2:01
Handwritten signature: Mary Campbell


B. Description of corner evidence found and/or method applied in restoring or reestablishing corner:

E-2- 1/4 cor. common to Sec. 4&5 - Found pile of stones and crockery and both Co. surveyor notes BT's in place. Could not find definite post location in stone pile so set position from record BT's. Set 1" x 36" galv. iron pipe with 4" DNR Alum. Cap by Wit. at stone and crockery pile . This position is believed to have been perpetuated by Co. Surveyor Frank Trumbull in the 1904 and is accepted as the best available evidence of the position of the original corner.

Reference Pt.-J - Found LLS cap #30079 on 1/2" X 18" rered per unrecorded LCRC - N26°10'E 22.94' of E-2. 0.4' NNE is face of 4" dia. steel fence post for fences N, S & W. P. Case indicates he found Co. Surveyor evidence to support this position using the dimensions as feet from the BT's. The evidence we found at these dimensions did not fit record bearings. Trumbull also used chains and links in his surveys not feet commonly. Capped 1/2" Rebar is not utilized as E2 in this survey.

C. Description of monument for corner and accessories established to perpetuate locating the position of the corner:

E-2 - DNR Monument in ring of Stone. Placed Fnd. Crockery around base of Monument. Place Carsonite post 1.5' E. S55°E 38.87' to set spike in CL 18"W. Pine Stp. remains (OCS) S42°W 42.57' to set spike in CL. 16" W. Pine Stp. remains (OCS) N28°E 61.73' to set N&T in W side 2" R. Oak scribed 'XBT' N63°E 26.06' to set N&T in N side 8" R. Maple scribed 'XBT'(PC) N35°W 73.39' to set N&T in NE side 32" R. Maple Clp. (PC) N3°E 42.82' to set N&T in W side 9" R. Oak (PC) S77°W 11.64' to set N&T in N. side 4" R. Maple scribed 'XBT'

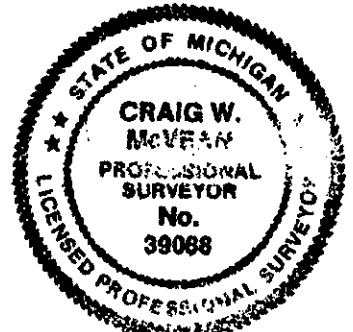

Signed by Craig W. McVean
Surveyor's Michigan License No. 39088

Date 10/14/1998