

SURVEY & REMONUMENTATION

DEC 13 2000

LAND CORNER RECORDATION CERTIFICATE

FILING REQUIREMENT OF ACT 74, Mich. P.A. 1970

SECTION

For corners in <u>Osceola</u>	Located in:	Corner Code#
1. Public Land Survey	<u>T 18 N</u>	<u>R 9 W</u> <u>E-11</u>
	<u>T</u>	<u>R</u>
	<u>T</u>	<u>R</u>
	<u>T</u>	<u>R</u>
2. Property Controlling S in Section	<u>T</u>	<u>R</u>
	<u>S</u>	<u>T</u> <u>R</u>
3. Miscellaneous S Property in Sec.	<u>T</u>	<u>R</u>
	<u>S</u>	<u>T</u> <u>R</u>
4. Lot No. _____ Recorded Plat _____		
5. Private Claims _____		

OSCEOLA COUNTY
REGISTERED SURVEYORS
00 OCT 11 AM 9:49
Robert L. Wetherell

Register of Deeds Stamp & File Number

	A	B	C	D	E	F	G	H	I	J	K	L	M
1													
2	6	5	4	3	2	1							
3													
4	7	8	9	10	11	12							
5													
6	18	17	16	15	14	13							
7													
8	19	20	21	22	23	24							
9													
10	30	29	28	27	26	25							
11													
12	31	32	33	34	35	36							
13													

I, Robert L. Wetherell, in a field survey on May 8, 2000, do hereby certify that under requirements of P.A. 74, Michigan P.A. of 1970, the corner points mentioned in lines 1 and 2 above were in conformance with regulations and rules therefore as required in the current manual of survey instructions of the United States Department of the Interior, Bureau of Land Management or by decree of a Court of Law and/or that the corner points mentioned in lines 3, 4, and 5 above were in conformance with the rules of the Michigan Board of Land Surveyors or by a Decree Of a Court of Law; established, re-established, monumented, re-monumented, recovered, found as expressed below:

E-11 - Section corner common to Sections 28, 29, 32 & 33. T18N, R9W

A. Description of original monument and accessories and/or subsequent restoration:

1838 - J. Hodgson, G.L.O.

#1 - 8" Sugar N89°W 17 Links
#2 - 7" Hemlock S8°E 35 Links

1974 - C. Cole, LS 17615

Found 5/8" Iron Pipe
#3 - Distance North to 1/4 Cor. = 2622.46'

1998 - R. L. Wetherell, LS 24624

L.C.R.C. - Liber 03, Pg. 175.
"Found 5/8" Pipe in line with old fence South and West".
#4 - 9" Cedar S72°E 32.04'
#5 - 14" W. Pine S3°E 62.23'
#6 - 3" Pipe in Concrete N89°E 2.25'
#7 - 8" Tamarack N15°E 56.71'

B. Description of corner evidence found and/or method applied in restoring or reestablishing corner:

I found a 5/8" Iron Pipe in line with old fences South and West (down). Corner is 9 feet South of two-track road East and West. The 3" pipe is a marker for the 5/8" iron.

Condition of the accessories are as follows: #1 Gone, #2 Gone, #3 Measured 2623.22', #4 Found in good condition, #5 Found in good condition, #6 Found in good condition, #7 Found in good condition (Hemlock).


C. Description of monument for corner and accessories established to perpetuate locating the position of the corner:

I replaced the 5/8" Pipe with Osceola County Remon Cap, and is accepted as a careful and faithful reestablishment of the position of the original corner.

9" Maple S58°W 14.76' (60d spike S. side)
9" Cedar S72°E 32.04' (60d spike S.W. side) #4
14" W. Pine S3°E 62.23' (60d spike E. side) #5
8" Hemlock N15°E 56.71' (60d spike W. side) #7
3" Pipe (3 1/2' above ground) in Concrete N89°E 2.25' #6

APPROVED LAND CORNER
P.A. 345 OF 1990
Osceola County

8-17-2000
R. L. W.

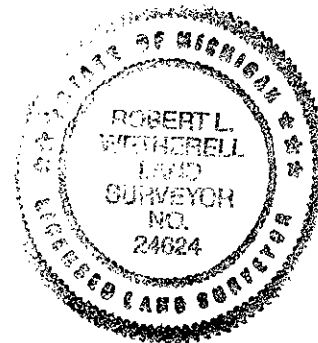

Signed by Robert L. Wetherell
Surveyor's Michigan License No. 24624

Date August 22, 2000

FORM APPROVED BY MICHIGAN STATE BOARD OF LAND SURVEYORS, JAN. 28, 1971
REVISED MAY 14, 1975
REVISED JAN. 1983
ADAPTED FOR WORD PROCESSING JANUARY, 1999