

SURVEY & REMONUMENTATION

FEB 12 1998

SECTION

LAND CORNER RECORDATION CERTIFICATE
Filing Requirement of Act 74, Mich. P.A. 1970

For corners in

Osceola <small>(County)</small>	Located In:	Corner Code #
1. Public Land Survey	T <u>18R 9W</u>	<u>E-13</u>
	T <u> R</u>	<u> </u>
	T <u> R</u>	<u> </u>
	T <u> R</u>	<u> </u>
2. Property Controlling in Section	S <u> T</u>	<u> R</u>
	S <u> T</u>	<u> R</u>
3. Miscellaneous Property in Sec.	S <u> T</u>	<u> R</u>
	S <u> T</u>	<u> R</u>

APPROVED LAND CORNER
P.A. 345 OF 1990
Osceola County

16 Oct. 1997
Matthew McClung

Register of Deeds Stamp & File Number

4. Lot No. _____, Recorded Plat _____
5. Private Claims _____

I, Matthew McClung in a field survey on Sept 12 1997 do hereby state that under requirements of P.A. 74, Michigan P.A. of 1970, the corner points mentioned in lines 1 and 2 above were in conformance with regulations and rules therefore as required in the current manual of survey instructions of the United States Department of the Interior, Bureau of Land Management or by a decree of a Court of Law and /or that the corner points mentioned in lines 3, 4 and 5 above were in conformance with the rules of the Michigan Board of Land Surveyors or by a Decree of a Court of Law; established, re-established, monumented, recovered, found as expressed below:

NOTE: Not more than 2 corners, all in the same town and range, may be recorded on this certificate.


	A	B	C	D	E	F	G	H	I	J	K	L	M
1													
2	6		5		4		3		2		1		
3													
4	7		8		9		10		11		12		
5													
6	18		17		16		15		14		13		
7													
8	19		20		21		22		23		24		
9													
10	30		29		28		27		26		25		
11													
12	31		32		33		34		35		36		
13													

A. Description of original monument and accessories and/or subsequent restoration:
The original corner was set by deputy surveyor John Hodgson on 21 November 1837. Set wood post 80.00 chains from East.
Sugar 18" N25E 20 Lks.
Ironwood 12" N41W 21 Lks

Janey Crawford
97 DEC 11 PM 2:10
OSCEOLA COUNTY
REGISTER OF DEEDS

B. Description of corner evidence found and/or method applied in restoring or reestablishing corner:
Hired backhoe to dig 18.48 feet West of found Hersey Corner. Excavated to 6 feet below road surface and found 1.4' X 1.2' X 0.8' rock, 2 pieces of crock and 4-5 smaller rocks. Exact location of large rock and pieces of crock could not be determined due to depth of excavation. Pinned off where rock and crock was thought to be found, and distance to Hersey corner measured 19.38 feet. I felt that pinned position of rock and crock could have been missed by .9 feet, so I placed Osceola County Monument 18.48 feet West of Hersey corner, as called by the Government notes. The monument is placed 6" below surface.

C. Description of monument for corner and accessories established to perpetuate locating the position of the corner:
Corner E-13. Osceola County Monument, which is a 3" brass cap mounted on a 1" pipe 30" in length.
18" Beech w/nail N48W 60.6 feet.
Treated Corner Fence Post S70E 67.3 feet.
12" R. Pine S22W 82.25 feet.
18" Maple w/nail N03W 44.70 feet.

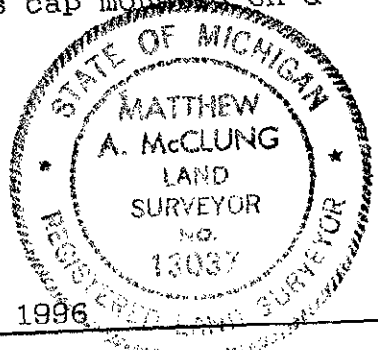

Signed by *Matthew McClung*
Surveyor's Michigan License No. 13037

Date Sept. 21, 1996