

FEB 18 1999

LAND CORNER RECORDATION CERTIFICATE
Filing Requirement of Act 74, Mich. P.A. 1970

SECTION

For corners in

Osceola (County)	Located In:	Corner Code #
1. Public Land Survey	T 18N R 9W	G-2
2. Property Controlling in Section	T _____ R _____	_____
3. Miscellaneous Property in Sec.	S _____ T _____ R _____	_____
	S _____ T _____ R _____	_____
	S _____ T _____ R _____	_____

APPROVED LAND CORNER
P.A. 345 OF 1990
Osceola County

Matthew M. Clary
8 Oct 1998

Register of Deeds Stamp & File Number

4. Lot No. _____, Recorded Plat _____

5. Private Claims _____

I, Craig W. McVean, in a field survey on April 13, 1998 do hereby state that under requirements of P.A. 74, Michigan P.A. of 1970, the corner points mentioned in lines 1 and 2 above were in conformance with regulations and rules therefore as required in the current manual of survey instructions of the United States Department of the Interior, Bureau of Land Management or by a decree of a Court of Law and for that the corner points mentioned in lines 3, 4 and 5 above were in conformance with the rules of the Michigan Board of Land Surveyors or by a Decree of a Court of Law; established, re-established, monumented, recovered, found as expressed below;

NOTE: Not more than 2 corners, all in the same town and range, may be recorded on this certificate.

A. Description of original monument and accessories and/or subsequent restoration


G-2 -GLO - Set post - J. Hodgson - 1838
Maple 7" N55°E 21 L.
Beech 6" S32°W 14 L.

B. Description of corner evidence found and/or method applied in restoring or reestablishing corner:

G-2 - 1/4 Corner common to Sec.'s 3 & 4, T18N, R9W. Fnd. no GLO evidence. Set 4" Alum. Cap on 1" x 3' long Galv. iron pipe single proportion to G-3 and G-1 T18N, R9W. Built Ring of Stone. N-S Sand Trail Rd. is 75' W. Monument is accepted as a careful and faithful re-establishment of the position of the original corner.

C. Description of monument for corner and accessories established to perpetuate locating the position of the corner:

G-2 - 4" DNR Alum. Cap on 1" x 3' long galv. iron pipe in ring of stone.
N1°W 72.88' to set N&T in W. Side 6" W. Oak - scribed 'XBT'.
S74°E 14.87' to set N&T in S. Side 5" R. Oak - scribed 'XBT'.
S28°W 4.29' to set N&T in W. Side 4" R. Oak.
N55°E 46.67' to set N&T in NW Side 6" R. Maple scribed 'XBT'.
Set Blue Carsonite post 1.5' N.

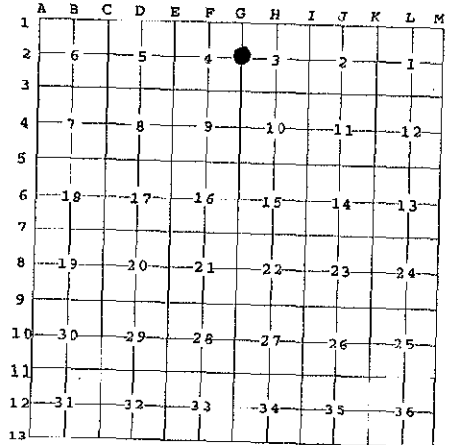

Wendy Campbell
98 DEC 17 PM 2:02
OSCEOLA COUNTY
REGISTER OF DEEDS



Signed by *Craig W. McVean*
Surveyor's Michigan License No. 39088

Date 10/21/1998