

SURVEY & REMONUMENTATION


DEC 13 2000

LAND CORNER RECORDATION CERTIFICATE

FILING REQUIREMENT OF ACT 74, Mich. P.A. 1970

SECTION

For corners in <u>Osceola</u>	Located in:	Corner Code#
1. Public Land Survey	T 18 N	R 9 W
	T	R
	T	R
	T	R
2. Property Controlling in Section	S T	R
	S T	R
3. Miscellaneous Property in Sec.	S T	R
	S T	R
4. Lot No. _____ Recorded Plat _____		
5. Private Claims _____		

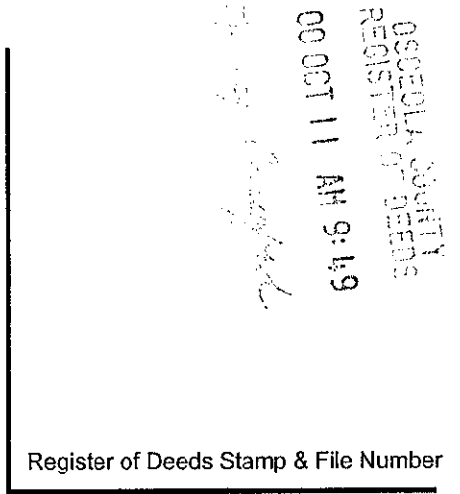

	A	B	C	D	E	F	G	H	I	J	K	L	M
1													
2	6	5	4	3	2	1							
3													
4	7	8	9	10	11	12							
5													
6	18	17	16	15	14	13							
7													
8	19	20	21	22	23	24							
9													
10	30	29	28	27	26	25							
11													
12	31	32	33	34	35	36							
13													

I, Robert L. Wetherell, in a field survey on May 8, 2000, do hereby certify that under requirements of P.A. 74, Michigan P.A. of 1970, the corner points mentioned in lines 1 and 2 above were in conformance with regulations and rules therefore as required in the current manual of survey instructions of the United States Department of the Interior, Bureau of Land Management or by decree of a Court of Law and/or that the corner points mentioned in lines 3, 4, and 5 above were in conformance with the rules of the Michigan Board of Land Surveyors or by a Decree Of a Court of Law; established, re-established, monumented, re-monumented, recovered, found as expressed below:

G-9 - Section corner common to Sectons 21, 22, 27 & 28, T18N, R9W

A. Description of original monument and accessories and/or subsequent restoration:

- | | | |
|---|---|---|
| <p>1838 - J. Hodgson, G.L.O.
 #1 - 14" Hemlock S65°E 16 Links
 #2 - 12" Hemlock N52°W 30 Links</p> <p>1894 - Co. Sur. Twp. Book
 Page 25
 #3 - 18" Pine S58°W 35 Links
 #4 - 12" Pine S19°E 70 Links
 #5 - 8" Oak N69°W 47 Feet</p> | <p>Undated - Co. Sur. Twp. Book
 Pg. 5
 "Well Point"
 #6 - 24" Pine N40°W 25.2'
 #7 - 20" Pine S50°E 89.3'</p> | <p>1977 - Ken Ostling, LS 10068
 L.C.R.C. - Liber 02, Pg. 8
 Found Well Point
 #8 - 6" Cherry S52°E 86.0'
 #9 - 21" Oak West 61.8'
 #10 - Cedar Post North 33'</p> |
|---|---|---|

B. Description of corner evidence found and/or method applied in restoring of reestablishing corner:

I found an old well point at the intersection of roads East and South and in line with old fence to North. It fits well with old accessory #5 from the Township notes (although I believe this entry by the County Surveyor was after 1894).


Condition of the accessories are as follows: #1 Gone, #2 Gone, #3 Gone, #4 Gone, #5 Found 34" Oak N66°W 47', #6 Gone, #7 Gone, #8 Found dead, #9 Found in good condition, #10 Found in good condition.

C. Description of monument for corner and accessories established to perpetuate locating the position of the corner:

I replaced the well point with a 1" x 18" pipe with Osceola County Remon Cap, and is accepted as a careful and faithful reestablishment of the position of the original corner.

- 26" R. Oak N86°W 62.56' (60d spike S. side) #9
- 11" R. Oak S16°W 109.49' (60d spike W. side)
- 18" W. Pine S17°E 111.19' (60d spike W. side)
- 11" R. Oak S71°E 95.95' (60d spike S. Side)

APPROVED LAND CORNER
 P.A. 345 OF 1990
 Osceola County
R. L. W.
8-17-2000

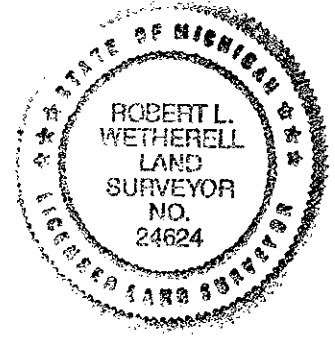

Signed by Robert L. Wetherell Date August 22, 2000
 Surveyor's Michigan License No. 24624

FORM APPROVED BY MICHIGAN STATE BOARD OF LAND SURVEYORS, JAN. 28, 1971
 REVISED MAY 14, 1975
 REVISED JAN. 1983
 ADAPTED FOR WORD PROCESSING JANUARY, 1989