

**SURVEY & REMONUMENTATION**

**FEB 12 1998**

**SECTION**

**LAND CORNER RECORDATION CERTIFICATE**  
Filing Requirement of Act 74, Mich. P.A. 1970

For corners in  
Osceola  
(County)

Located In:	Corner Code #
T18NR 9W	G-13
T ___ R ___	_____
T ___ R ___	_____
T ___ R ___	_____
S ___ T ___ R ___	_____
S ___ T ___ R ___	_____
S ___ T ___ R ___	_____
S ___ T ___ R ___	_____

APPROVED LAND CORNER  
P.A. 305 OF 1990  
Osceola County

*16 Oct 1997*  
*Matthew McClung*

Register of Deeds Stamp & File Number

1. Public Land Survey

2. Property Controlling in Section

3. Miscellaneous Property in Sec.

4. Lot No. \_\_\_\_\_, Recorded Plat \_\_\_\_\_  
5. Private Claims \_\_\_\_\_

I, Matthew McClung, in a field survey on Sept 21, 1997 do hereby state that under requirements of P.A. 74, Michigan P.A. of 1970, the corner points mentioned in lines 1 and 2 above were in conformance with regulations and rules therefore as required in the current manual of survey instructions of the United States Department of the Interior, Bureau of Land Management or by a decree of a Court of Law and/or that the corner points mentioned in lines 3, 4 and 5 above were in conformance with the rules of the Michigan Board of Land Surveyors or by a Decree of a Court of Law; established, re-established, monumented, recovered, found as expressed below:

A	B	C	D	E	F	G	H	I	J	K	L	M
1												
2	6	5	4	3	2	1						
3												
4	7	8	9	10	11	12						
5												
6	18	17	16	15	14	13						
7												
8	19	20	21	22	23	24						
9												
10	30	29	28	27	26	25						
11												
12	31	32	33	34	35	36						
13												


NOTE: Not more than 2 corners, all in the same town and range, may be recorded on this certificate.

A. Description of original monument and accessories and/or subsequent restoration:  
The original corner was set by deputy surveyor John Hodgson on 1 November 1837. Set wood post 80.00 chains from East.  
Sugar 10" N75E 16 lks.  
Hemlock 14" N46W 27 lks.

Act 132, Liber 562, Pages 654,655,656. Map of State Project No.75-44.  
No Witnesses. (continued on back)

B. Description of corner evidence found and/or method applied in restoring or reestablishing corner:  
Found Jan Fokens Iron and Cap 2" below surface, 4 feet South of centerline of East and West Road. Excavated to 32" and found 3/4" Pipe 0.8 feet North and 0.21 West of Fokens Iron and Cap. Placed 30" Osceola County Monument over 3/4" pipe 5" below road surface.

C. Description of monument for corner and accessories established to perpetuate locating the position of the corner:  
Corner G-13. Osceola County Monument, which is a 3" brass cap mounted on a 1" pipe 30" in length.  
8" apple S16E 36.1 feet.  
Power Pole S70W 85.45 feet. O.B.P.  
5" Ash N5E 123.45 feet.  
6' X 4' x 2' Rock N56W 130.04 feet.

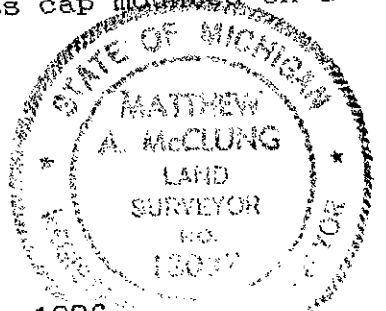

Signed by Matthew McClung  
Surveyor's Michigan License No. 13037

Date Sept. 21, 1996

SURVEY &  
REMONUMENTATION

FEB 12 1998

SECTION

OSCEOLA COUNTY  
REGISTER OF DEEDS

97 DEC 11 PM 2:10

*Nancy Crawford*

P.A. Act 74, Liber 3, Page 61, by Fokens, Dated 4-26-93.  
S05W-17.80' N. face road sign post.  
S70W 85.48' Nail & LSC tag in S. face of Power Pole.  
N65W 89.15' Orange "+" on S. face of 4" gas marker pipe.  
N68E 42.80' W face of Stop sign post.  
West 8.85' Re-rod w/cap L.S. 21567 @ NW Cor Section 3, T17N-R9W.