

**SURVEY & REMONUMENTATION**

**FEB 12 1998**

**SECTION**

**LAND CORNER RECORDATION CERTIFICATE**  
Filing Requirement of Act 74, Mich. P.A. 1970

For corners in  
Osceola  
(County)

Located In:	Corner Code #
<u>T18NR 9W</u>	<u>I-13</u>
T___R___	_____
T___R___	_____
T___R___	_____
S___T___R___	_____
S___T___R___	_____
S___T___R___	_____
S___T___R___	_____

- 1. Public Land Survey
- 2. Property Controlling in Section
- 3. Miscellaneous Property in Sec.

APPROVED LAND CORNER  
P.A. 345 OF 1990  
Osceola County  
*Matthew McClung*  
Register of Deeds Stamp & File Number

4. Lot No. \_\_\_\_\_, Recorded Plat \_\_\_\_\_  
5. Private Claims \_\_\_\_\_

I, Matthew McClung, in a field survey on Oct. 7, 1997 do hereby state that under requirements of P.A. 74, Michigan P.A. of 1970, the corner points mentioned in lines 1 and 2 above were in conformance with regulations and rules therefore as required in the current manual of survey instructions of the United States Department of the Interior, Bureau of Land Management or by a decree of a Court of Law and /or that the corner points mentioned in lines 3, 4 and 5 above were in conformance with the rules of the Michigan Board of Land Surveyors or by a Decree of a Court of Law; established, re-established, monumented, recovered, found as expressed below:


NOTE: Not more than 2 corners, all in the same town and range, may be recorded on this certificate.

A	B	C	D	E	F	G	H	I	J	K	L	M
6		5		4		3		2		1		
7		8		9		10		11		12		
18		17		16		15		14		13		
19		20		21		22		23		24		
30		29		28		27		26		25		
31		32		33		34		35		36		

A. Description of original monument and accessories and/or subsequent restoration:  
The original corner was set by deputy surveyor John Hodgson on 21 November 1837. Set wood post 80.00 chains from East.  
Beech 7" N35E 5 Lks.  
Hemlock 10" N40W 19 lks.  
From 1891 to 1904 approximately, Osecola County had a remonumentation program, in which surveyors Temple and Trumbull, did the work. For the most part, a 3" glazed tile filled with cinders from a forge, were placed at each government set corner in the township. There were supposed to be 3 tile per corner, placed atop of each other, (continued on back)

B. Description of corner evidence found and/or method applied in restoring or reestablishing corner:  
Found DNR Monument 3" above surface 3 1/2" West of center of tile. This corner is recorded by the DNR as the Southeast Corner of Section 34, T18N-R9W, Township of Cedar, State project 75-44, and was so approved by the Osceola County Peer Group. The peer group accepted the tile as the standard corner due to government line call "16" Pine 670' W. of corner", which measured 674.0' west of tile corner.

C. Description of monument for corner and accessories established to perpetuate locating the position of the corner:  
Corner I-13 is a DNR Monument set 3 1/2" west of center of Clay tile.  
Corner is marked Sec.s 34 & 35 T18N-R9W Cedar Township.  
4" Maple N48W 16.02 feet.  
8" R. Oak North 35.85 feet. O.B.T.  
14" Poplar N10E 24.54 feet. O.B.T.  
NE Cor. Section 3 T17N-R9W east 44.2 feet.

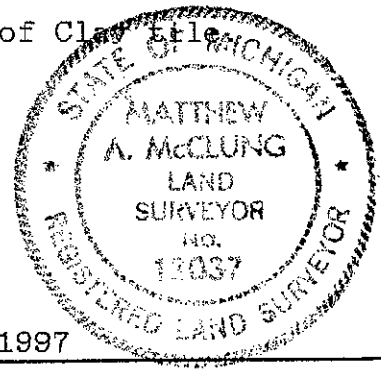

Signed by *Matthew McClung*  
Surveyor's Michigan License No. 13037

Date Oct 7, 1997

SURVEY &  
REMONUMENTATION

FEB 12 1998

SECTION

OSCEOLA COUNTY  
REGISTER OF DEEDS

97 DEC 11 PM 2:10

*Nancy Crawford*

thereby making the corner 4 feet long. Sometimes a solid tile, with a cross in the top was used, and sometimes a 1/2" iron bars were added to the tile. Notes of the work were kept in ledgers, and given to the townships, and 5 of the townships have been recorded in to the County records.

Act. 74, Liber 2, Page 12

Dated 16 Dec. 1977, by Ostling.

Found tile Monument at what we conclude to be standard corner for Sec. 34 & 35. Set DNR Monument and cedar post at tile monument. 7" R. Oak N05W 35.5'. 11" W. Birch S80W 18.6' E & W random Due North 17' NE Sec. 3 T17N-R9W Due E. 44.4

L.C.R.C. Liber 3, Page 66. By Fokens.

I-13, Southeast Corner Sec, 34 1" pipe W/DNR Cap.

N10E 24.54' Nail & LSC Tag#21567 in SE face 14" Poplar.

North 35.85' Nail & LSC Tag#21567 in E face 8" R. Oak

East 44.78' 1" pipe/DNR cap, NE Cor. Sec. 3, T17N, R9W.

Act. 132 by Fokens

Liber 562, Pages 654, 655, & 656.

Map of State project No. 75-44.