

SURVEY &  
REMONUMENTATION

OSCEOLA COUNTY  
REGISTER OF DEEDS

FEB 25 1994

LAND CORNER RECORDATION CERTIFICATE 93 DEC 10 PM 2:49  
Filing Requirement of Act 74, Mich. P.A. 1970

For corners in

COMMISSION

*Nancy Crawford*

	Located In:	Corner Code #
Osceola		
1. Public Land Survey	T18N R9W	J-11
	T ___ R ___	_____
	T ___ R ___	_____
	T ___ R ___	_____
2. Property Controlling in Section	S ___ T ___ R ___	_____
	S ___ T ___ R ___	_____
3. Miscellaneous Property in Sec.	S ___ T ___ R ___	_____
	S ___ T ___ R ___	_____

APPROVED LAND CORNER  
P.A. 345 OF 1990  
Osceola County

*Matthew McClung*  
8 Dec 1993  
Register of Deeds Stamp & File Number

4. Lot No. \_\_\_\_\_, Recorded Plat \_\_\_\_\_  
5. Private Claims \_\_\_\_\_

I, Matthew McClung a field survey on November 30, 19 93, do hereby certify that under requirements of P.A. 74, Michigan P.A. of 1970, the corner points mentioned in lines 1 and 2 above were in conformance with regulations and rules therefore as required in the current manual of survey instructions of the United States Department of the Interior, Bureau of Land Management or by a decree of a Court of Law and/or that the corner points mentioned in lines 3, 4 and 5 above were in conformance with the rules of the Michigan Board of Land Surveyors or by a Decree of a Court of Law; established, re-established, monumented, re-monumented, recovered, found as expressed below:

**NOTE: Not more than 4 corners, all in the same town and range, may be recorded on this certificate.**

	A	B	C	D	E	F	G	H	I	J	K	L	M
2	6	5	4	3	2	1							
3													
4	7	8	9	10	11	12							
5													
6	18	17	16	15	14	13							
7													
8	19	20	21	22	23	24							
9													
10	30	29	28	27	26	25							
11													
12	31	32	33	34	35	36							
13													

A. Description of original monument and accessories and/or subsequent restoration:

The original corner was set by deputy surveyor John Hodgson on 10 June 1838. Set wood post 40 chains from East.

Hemlock 11" N41E 10 lks.  
Hemlock 11" S21W 16 lks.


This corner is recorded in the Cedar Twp. Book, pages 38 & 39, as corner "7"

This corner has a PA. 74 certificate, dated Aug. 3, 1977, by Pierson.

Two PA. 132 surveys are recorded.

B. Description of corner evidence found and/or method applied in restoring or reestablishing corner:

Found 3/4" pipe in E & W gravel road to east side of road to north. Pipe is 14" below road surface, with top 10" bent to east. I set Osceola County Monument over Pipe, where it goes straight down, 8" below road surface. I think the county road commission, bent the pipe, as soil is filled with wood chips.

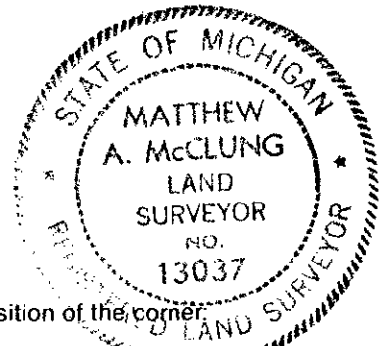

C. Description of monument for corner and accessories established to perpetuate locating the position of the corner:

Corner J-11. Osceola County Monument, which is a 3" brass cap mounted on a 1" pipe 18" in length.

8" W. Pine S58w 54.68 feet. OBT  
East of twin 18" R. Oak South 28.85 feet. OBT  
2" pipe 4 ft. high (pipe line marker) N22W 61.35 feet.  
12" sugar Maple S75W 70.75 feet.

Signed by *Matthew McClung* Date November 8, 1993  
Surveyor's Michigan License No. 13037

FORM APPROVED BY MICHIGAN STATE BOARD OF LAND SURVEYORS, JAN. 28, 1971  
REVISED MAY 14, 1975  
REVISED JAN., 1983