

SURVEY &
REMONUMENTATION

JAN 17 1996

COMMISSION

LAND CORNER RECORDATION CERTIFICATE
Filing Requirement of Act 74, Mich. P.A. 1970

For corners in

Osceola
(County)

Located In: Corner Code #

1. Public Land Survey	T	18N	R	10W	A-3
	T		R		
	T		R		
	T		R		
2. Property Controlling in Section	S		T	R	
	S		T	R	
3. Miscellaneous Property in Sec.	S		T	R	
	S		T	R	

APPROVED LAND CORNER
P.A. 345 OF 1990
Osceola County

19 Oct. 1995
Matthew McClung

Register of Deeds Stamp & File Number

4. Lot No. _____, Recorded Plat _____
5. Private Claims _____

Matthew McClung October 14, 1995

I, _____, in a field survey on _____, 19____, do hereby certify that under requirements of P.A. 74, Michigan P.A. of 1970, the corner points mentioned in lines 1 and 2 above were in conformance with regulations and rules therefore as required in the current manual of survey instructions of the United States Department of the Interior, Bureau of Land Management or by a decree of a Court of Law and/or that the corner points mentioned in lines 3, 4 and 5 above were in conformance with the rules of the Michigan Board of Land Surveyors or by a Decree of a Court of Law; established, re-established, monumented, re-monumented, recovered, found as expressed below:

NOTE: Not more than 4 corners, all in the same town and range, may be recorded on this certificate.

	A	B	C	D	E	F	G	H	I	J	K	L	M
2	6		5		4		3		2		1		
3													
4	7		8		9		10		11		12		
5													
6	18		17		16		15		14		13		
7													
8	19		20		21		22		23		24		
9													
10	30		29		28		27		26		25		
11													
12	31		32		33		34		35		36		
13													

A. Description of original monument and accessories and/or subsequent restoration:

The original corner was set by deputy surveyor John Hodgson on 26 Nov. 1837. Set wood post 80.00 chains from South.
Sugar 8" S71W 28 lks.
Beech 10" N45W 51 lks.

B. Description of corner evidence found and/or method applied in restoring or reestablishing corner:

Found 16 penny nail in the road intersection. I found the 1/16th and 1/4 corners to South and doubled over. This position fell 11.85 feet South of East and West Centerline 2 feet East of Nail. I also doubled over the 1/16th and 1/4 Corners to the West. This position fell 12.24 feet to the North of Centerline and 1 feet East of Nail. The peer group instructed me to set the Corner equal distant from the 1/4 Corners to the North and South. The Corner falls 1.90 feet (approx.) South of centerline and is 2" below Surface.

C. Description of monument for corner and accessories established to perpetuate locating the position of the corner:


Corner A-3. Osceola County Monument, which is a 3" brass cap mounted on a 1" pipe 18" in length.
Telephone Pole S18E 92.10 feet.
2" Red Pine N20E 66.35 feet.
Power Pole N60W 90.65 feet.
2" White Pine S45W 61.00 feet.

OSCEOLA COUNTY
REGISTER OF DEEDS

95 NOV 13 PM 4:52

Nancy Crawford

Date October 14, 1995

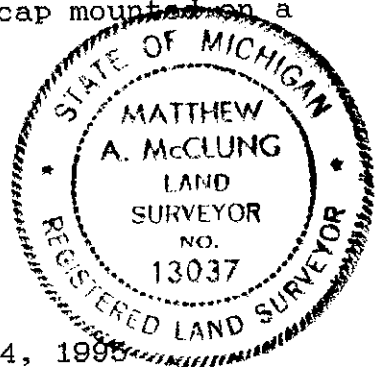

Signed by *Matthew McClung*

Surveyor's Michigan License No. 13037