

**SURVEY &
REMONUMENTATION**

OCT 29 1996

COMMISSION

LAND CORNER RECORDATION CERTIFICATE
Filing Requirement of Act 74, Mich. P.A. 1970

For corners in

Osceola (County)	Located in:	Corner Code #
1. Public Land Survey	T18NR10W	A-4
	T ___ R ___	_____
	T ___ R ___	_____
	T ___ R ___	_____
2. Property Controlling in Section	S ___ T ___ R ___	_____
	S ___ T ___ R ___	_____
3. Miscellaneous Property in Sec.	S ___ T ___ R ___	_____
	S ___ T ___ R ___	_____

APPROVED LAND CORNER
P.A. 345 OF 1990
Osceola County

Matthew McClung
24 Sept 1996

Register of Deeds Stamp & File Number

4. Lot No. _____, Recorded Plat _____
5. Private Claims _____

Matthew McClung, in a field survey on 9-20, 1996 hereby state that under requirements of P.A. 74, Michigan P.A. of 1970, the corner points mentioned in lines 1 and 2 above were in conformance with regulations and rules therefore as required in the current manual of survey instructions of the United States Department of the Interior, Bureau of Land Management or by a decree of a Court of Law and /or that the corner points mentioned in lines 3, 4 and 5 above were in conformance with the rules of the Michigan Board of Land Surveyors or by a Decree of a Court of Law; established, re-established, monumented, recovered, found as expressed below:

NOTE: Not more than 2 corners, all in the same town and range, may be recorded on this certificate.


	A	B	C	D	E	F	G	H	I	J	K	L	M
1													
2	6		5		4		3		2		1		
3													
4	7		8		9		10		11		12		
5													
6	10		17		16		15		14		13		
7													
8	19		20		21		22		23		24		
9													
10	30		29		28		27		26		25		
11													
12	31		32		33		34		35		36		
13													

A. Description of original monument and accessories and/or subsequent restoration:
The original corner was set by deputy surveyor John Hodgson on 10 June 1838. Set wood post 40.00 chains from South.
Beech 10" S50W 13 lks.
Sugar 10" N15W 23lks.
I have shown one LCRC; Liber 2, Page 339

B. Description of corner evidence found and/or method applied in restoring or reestablishing corner:
Found cement monument 2" below surface in fence row to east.

C. Description of monument for corner and accessories established to perpetuate locating the position of the corner:
Corner A-4. Is a Cement Monument, commonly used in Plats.

- Clump of 3-36" Cherry S78E 30.90 feet.
- 12" n. Pine N82W 34.50 feet.
- 8" W. Ash N20W 77.75 feet.
- 10" Ash N42E 41.78 feet.

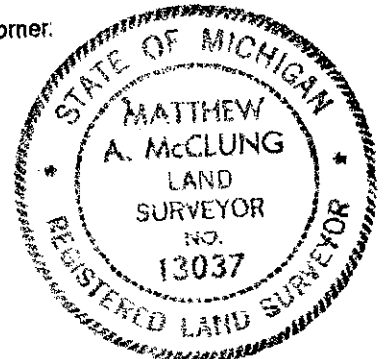

Signed by *Matthew McClung*
Surveyor's Michigan License No. 13037

Date September 20, 1996