

LAND CORNER RECORDATION CERTIFICATE
Filing Requirement of Act 74, Mich. P.A. 1970

For corners in

Osceola
 (County)

Located In:

Corner Code #

18N 10W

D-3

- | | | | |
|------------------------------------|---|---|-------|
| 1. Public Land Survey | T | R | _____ |
| | T | R | _____ |
| | T | R | _____ |
| | T | R | _____ |
| 2. Property Controlling in Section | S | T | R |
| | S | T | R |
| 3. Miscellaneous Property in Sec. | S | T | R |
| | S | T | R |

APPROVED LAND CORNER
 P.A. 345 OF 1990
 Osceola County

19 Oct. 1995
Matthew McClung

Register of Deeds Stamp & File Number

4. Lot No. _____, Recorded Plat _____
 5. Private Claims _____

Matthew McClung October 14, 1995

I, _____, in a field survey on _____, 19____, do hereby certify that under requirements of P.A. 74, Michigan P.A. of 1970, the corner points mentioned in lines 1 and 2 above were in conformance with regulations and rules theretofore as required in the current manual of survey instructions of the United States Department of the Interior, Bureau of Land Management or by a decree of a Court of Law and/or that the corner points mentioned in lines 3, 4 and 5 above were in conformance with the rules of the Michigan Board of Land Surveyors or by a Decree of a Court of Law; established, re-established, monumented, re-monumented, recovered, found as expressed below:

A	B	C	D	E	F	G	H	I	J	K	L	M
2	6	5	4	3	2	1						
3												
4	7	8	9	10	11	12						
5												
6	18	17	16	15	14	13						
7												
8	19	20	21	22	23	24						
9												
10	30	29	28	27	26	25						
11												
12	31	32	33	34	35	36						
13												

NOTE: Not more than 4 corners, all in the same town and range, may be recorded on this certificate.

A. Description of original monument and accessories and/or subsequent restoration:

The original corner was set by deputy surveyor John Hodgson on 10 June 1838. Set wood post 39.88 chains from East.
 Beech 8" S12E 15 lks.
 Beech 8" N74W 12 lks.

County survey Records Lincoln Township Book, pages 14 and 15, 16 and 17.

I have shown 2 LCRC certificates 1 by Blass and 1 by Erickson.


B. Description of corner evidence found and/or method applied in restoring or reestablishing corner:

Found Rail Road Rail 6" below surface. Placed Osceola County Monument over Center of Rail 1" below surface on slant.

OSCEOLA COUNTY
 REGISTER OF DEEDS

96 MAR -7 AM 10:22

Nancy Crawford

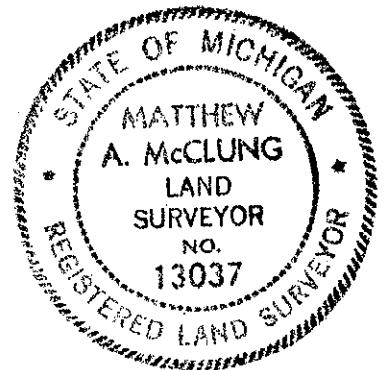

C. Description of monument for corner and accessories established to perpetuate locating the position of the corner:

Corner D-3. Osceola County Monument, which is a 3" brass cap mounted on a 1" pipe 18" in length.
 Southeast Corner of Garage N20W 165.56 feet.
 8" Red Pine N30E 48.84 feet. M.D.S.H. Tag O.B.T.
 Telephone Pedestal N80W 235.45 feet.
 Power Pole South 30.97 feet.

Signed by *Matthew McClung*

Date October 14, 1995

Surveyor's Michigan License No. 13037