LAND CORNER RECORDATION CERTIFICATE
Filing Requirement of Act 74, Mich. P.A. 1970

For corners in
Osceola
(County)

	Located In:	Corner Code ##
	18N 10W	E-2
1. Public Land Survey	T ____ R ____	
	T ____ R ____	
	T ____ R ____	
	T ____ R ____	
2. Property Controlling	S ____ T ____ R ____	
in Section	S ____ T ____ R ____	
3: Miscellaneous	S ____ T ____ R ____	
Property in Sec.	S ____ T ____ R ____	

APPROVED LAND CORNER
P.A. 345 OF 1990
Osceola County
19 OCT. 1995
Matthew McClung
Register of Deeds Stamp & File Number

4. Lot No. _____ , Recorded Plat _____
5. Private Claims _____

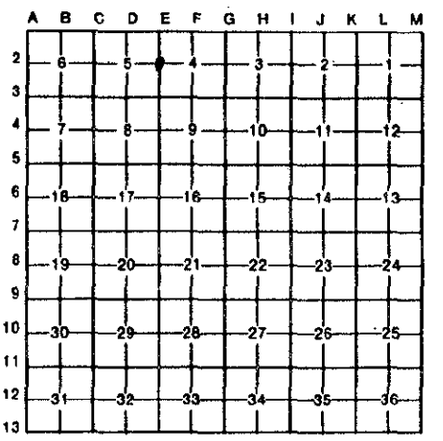

I, Matthew McClung, in a field survey on October 14, 95, 19 _____, do hereby certify that under requirements of P.A. 74, Michigan P.A. of 1970, the corner points mentioned in lines 1 and 2 above were in conformance with regulations and rules therefore as required in the current manual of survey instructions of the United States Department of the Interior, Bureau of Land Management or by a decree of a Court of Law and/or that the corner points mentioned in lines 3, 4 and 5 above were in conformance with the rules of the Michigan Board of Land Surveyors or by a Decree of a Court of Law; established, re-established, monumented, re-monumented, recovered, found as expressed below:

NOTE: Not more than 4 corners, all in the same town and range, may be recorded on this certificate.

A. Description of original monument and accessories and/or subsequent restoration:

The original corner was set by deputy surveyor John Hodgson on 10 June 1838. Set wood post 40.00 chains from South.
Hemlock 10" N57E 28 lks.
Beech 7" N28W 19 lks.
I have shown one LCRC certificate.

B. Description of corner evidence found and/or method applied in restoring or reestablishing corner:

Found 1/2" pipe 12" below surface. Pipe in fence rows East and West. Corner is in a fill area and original would be buried 36" deep. Set Osceola County Monument 6" below surface over pipe.

OSCEOLA COUNTY
REGISTER OF DEEDS
96 MAR -7 AM 10:22
Nancy Crawford

STATE OF MICHIGAN
MATTHEW A. McCLUNG
LAND SURVEYOR
NO. 13037
REGISTERED LAND SURVEYOR

C. Description of monument for corner and accessories established to perpetuate locating the position of the corner:

Corner E-2. Osceola County Monument, which is a 3" brass cap mounted on a 1" pipe 18" in length.
10" White Ash N72W 47.80 feet.
5" Elm S48W 47.88 feet. O.B.T.
3" White Ash N70E 24.96 feet.
Cap and Iron East 33.00 feet.

Signed by Matthew McClung Date October 14, 1995
Surveyor's Michigan License No. 13037

FORM APPROVED BY MICHIGAN STATE BOARD OF LAND SURVEYORS, JAN. 28, 1971
REVISED MAY 14, 1975
REVISED JAN., 1983