

FEB 10 1999

SECTION

LAND CORNER RECORDATION CERTIFICATE
Filing Requirement of Act 74, Mich. P.A. 1970

OSCEOLA COUNTY
State of Michigan
Received For Record

Nov. 23, 1998 at 10:38 Am

NANCY CRAWFORD
Register of Deeds

APPROVED LAND CORNER
P.A. 345 OF 1990
Osceola County

Matthew McClung
27 Oct 1998

Register of Deeds Stamp & File Number

For corners in

Osceola

(County)

Located In:

Corner Code #

1. Public Land Survey

TBN R OW

E-6

T R

T R

T R

2. Property Controlling
in Section

S T R

S T R

3. Miscellaneous
Property in Sec.

S T R

S T R

4. Lot No. _____, Recorded Plat _____

5. Private Claims _____

I, Matthew McClung, in a field survey on 6-24, 1998 do hereby state that under requirements of P.A. 74, Michigan P.A. of 1970, the corner points mentioned in lines 1 and 2 above were in conformance with regulations and rules therefore as required in the current manual of survey instructions of the United States Department of the Interior, Bureau of Land Management or by a decree of a Court of Law and /or that the corner points mentioned in lines 3, 4 and 5 above were in conformance with the rules of the Michigan Board of Land Surveyors or by a Decree of a Court of Law; established, re-established, monumented, recovered, found as expressed below:

NOTE: Not more than 2 corners, all in the same town and range, may be recorded on this certificate.

	A	B	C	D	E	F	G	H	I	J	K	L	M
1													
2		6		5		4		3		2		1	
3													
4		7		8		9		10		11		12	
5													
6		10		17		16		15		14		13	
7													
8		19		20		21		22		23		24	
9													
10		30		29		28		27		26		25	
11													
12		31		32		33		34		35		36	
13													

A. Description of original monument and accessories and/or subsequent restoration:

The original corner was set by deputy surveyor John Hodgson on 10 June 1838. Set wood post 40.00 chains from South Beech 12" S31W 19 lks. Sugar 7" S53E 23 lks.


Act 74, Liber 2, page 88, Fd 5/8" rod.	Act 132, Liber 401, page 32-34.
S70E 53.13' 21" Cherry	21" Cherry N70E 53.13'
S40E 66.03' 20" Cherry	20" Cherry S40E 66.03'
N80W 38.44' 10" Cherry	10" Cherry N80W 38.44'
N25W 52.17' 6" Cherry	

B. Description of corner evidence found and/or method applied in restoring or reestablishing corner:

Excavated to 6" and found 5/8" iron rod. Excavated to 32" into sub soil, removed rod and found, or heard no other evidence of corner. Placed Osceola County Monument over 5/8" rod 6" below surface, in position of original found rod. Corner is in fence row to West and in centerline of North and South road.

C. Description of monument for corner and accessories established to perpetuate locating the position of the corner:

Corner E-6 The corner is an Osceola County Monument, which is a 3" brass cap mounted on a 1" pipe, 18" in length.
P. Pole N10W 165.7 feet.
16" Cherry West 37.7 feet. (Nail)
Iron East 33.0 feet.
8" R. Pine N60E 60.1 feet. (Nail)

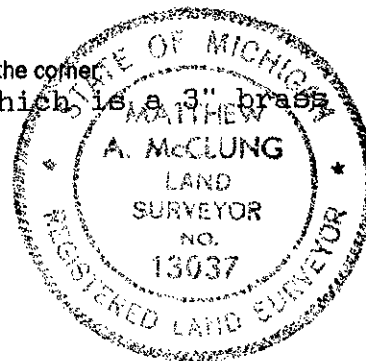

Signed by Matthew McClung 13037
Surveyor's Michigan License No. _____

Date 23 Nov. 98