

FEB 24 2000

LAND CORNER RECORDATION CERTIFICATE

FILING REQUIREMENT OF ACT 74, Mich. P.A. 1970

SECTION

For corners in Osceola	Located in:	Corner Code#
1. Public Land Survey	T 18 N R 10W	F-3
	T R	
	T R	
	T R	
2. Property Controlling s in Section	T R	
	S T R	
3. Miscellaneous Property in Sec.	S T R	
	S T R	
4. Lot No. _____ Recorded Plat _____		
5. Private Claims _____		

OSCEOLA COUNTY
REGISTER OF DEEDS
99 NOV 19 PM 12:10
Yancy Crawford

Register of Deeds Stamp & File Number

	A	B	C	D	E	F	G	H	I	J	K	L	M
1													
2	6	5	4	3	2	1							
3													
4	7	8	9	10	11	12							
5													
6	18	17	16	15	14	13							
7													
8	19	20	21	22	23	24							
9													
10	30	29	28	27	26	25							
11													
12	31	32	33	34	35	36							
13													

I, Robert L. Wetherell, in a field survey on October 1 1999, do hereby certify that under requirements of P.A. 74, Michigan P.A. of 1970, the corner points mentioned in lines 1 and 2 above were in conformance with regulations and rules therefore as required in the current manual of survey instructions of the United States Department of the Interior, Bureau of Land Management or by decree of a Court of Law and/or that the corner points mentioned in lines 3, 4, and 5 above were in conformance with the rules of the Michigan Board of Land Surveyors or by a Decree Of a Court of Law, established, re-established, monumented, re-monumented, recovered, found as expressed below:

NOTE: ONLY ONE CORNER MAY BE RECORDED ON THIS CERTIFICATE.

1/4 Corner Common to Section 4 & 9

Description of original monument and accessories and/or subsequent restoration:

1838-J. Hodgson
#1-18" Beech N52W 33 Lk.
#2-11" Beech N26E 27 Lk.

1972-Erickson LS 16929
LCRC
L. 1, Pg. 73
Fd. PK Nail N¼; per MDSH witnesses
#3-24" Elm South 54.80'
#4-18" Elm N45E 45.90'
#5-18" Elm N45W 43.5'

1978-Hooth LS 7966
LCRC
L. 2, Pg. 89
Fd. PK Nail
Set: 5/8" X 14" Rod
#4- 22" Elm stump N40E 45.90'
#6-26" Maple N60W 83.42'
#5- 22" Elm N35W 43.50'
#7- 8" R. Pine N05W 33.99'

1987-Erickson LS 19929

LCRC
L. 2, Pg. 266
Fd. 18" X 1" pipe With O.C.R.C. Cap Ashton Rd
19.55' W. of NB Lane EM
#8- SE Face of N. Pier Col. N40W 25.57'
#9- SE Face of N. Pier Col. N65W 16.45'
#10- NE Face of N. Pier Col. S65W 15.95'
#11- NE Face of S. Pier Col. S40W 23.47'

B. Description of corner evidence found and/or method applied in restoring of reestablishing corner:


I found an Osceola County Monument +/- 19' West of North Bound US131 under Ashton Rd. Overpass

Condition of the accessories are as follow: #1 Gone, #2 Gone, #3Gone, #4 Gone, #5Gone, #6 Gone, #7 Gone, #8 Found @ 24.63', #9 Found in good condition, #10 Found in good condition and #11 Found in good condition.

C. Description of monument for corner and accessories established to perpetuate locating the position of the corner:

I accepted the Osceola County Monument (1 1/2" pipe with an Osceola County Remon Cap) as a substantial marker of the corner and is accepted as a careful and faithful reestablishment of the position of the original corner.

SE Face of N. Pier Col. N40W 24.63' - #8
SE Face of N Pier Col. N65W 16.45' - #9
NE Face of N Pier Col. S65W 15.95' - #10
NE Face of S Pier Col. S40W 23.47' - #11

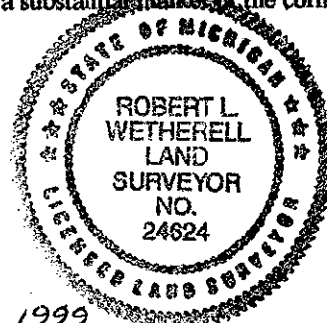

Signed by *Robert L. Wetherell*

Date Nov-9, 1999

Surveyor's Michigan License No. 24624

APPROVED LAND CORNER
P.A. 345 OF 1990
Osceola County

10-21-99
R. L. W.

FORM APPROVED BY MICHIGAN STATE BOARD OF LAND SURVEYORS, JAN. 28, 1971
REVISED MAY 14, 1975
REVISED JAN., 1983
ADAPTED FOR WORD PROCESSING JANUARY, 1988