

SURVEY & REMONUMENTATION

DEC 13 2000

SECTION

LAND CORNER RECORDATION CERTIFICATE

FILING REQUIREMENT OF ACT 74, Mich. P.A. 1970

For corners in Osceola	Located in:	Corner Code#
1. Public Land Survey	T 18 N R 10 W	G-1
	T R	
	T R	
	T R	
2. Property Controlling in Section	S T R	
	S T R	
3. Miscellaneous Property in Sec.	S T R	
	S T R	
4. Lot No. _____ Recorded Plat _____		
5. Private Claims _____		

OSCEOLA COUNTY
 REGISTER OF DEEDS
 00 MAY - 5 PM 2:50
George Campbell

Register of Deeds Stamp & File Number

	A	B	C	D	E	F	G	H	I	J	K	L	M
1													
2	6	5	4	3	2	1							
3													
4	7	8	9	10	11	12							
5													
6	18	17	16	15	14	13							
7													
8	19	20	21	22	23	24							
9													
10	30	29	28	27	26	25							
11													
12	31	32	33	34	35	36							
13													

I, Robert L. Wetherell, in a field survey on March 22, 2000, do hereby certify that under requirements of P.A. 74, Michigan P.A. of 1970, the corner points mentioned in lines 1 and 2 above were in conformance with regulations and rules therefore as required in the current manual of survey instructions of the United States Department of the Interior, Bureau of Land Management or by decree of a Court of Law and/or that the corner points mentioned in lines 3, 4, and 5 above were in conformance with the rules of the Michigan Board of Land Surveyors or by a Decree Of a Court of Law; established, re-established, monumented, re-monumented, recovered, found as expressed below:

G-1 - Sec. corner common to Sections 3 & 4, T18N, R10W, on Twp. line.

A. Description of original monument and accessories and/or subsequent restoration:

- | | | |
|--------------------------------------|---|---|
| 1838 - J. Hodgson, G.L.O. | 1975 - M. McClung, LS 13037 | 1978 - D. Hooth, LS 7966. (M.S.H.D.) |
| #1 - 16" Hemlock S25°E 28 Links | L.C.R.C. - Liber 01, Pg. 399 | "Found 1" Iron along side 3" Brass Disk" |
| #2 - 11" Hemlock S13°W 20 Links | "Found iron in road grade set brass cap". | #5 - 4" Poplar N35°E 64.26' |
| "Intersected 19 Links West of Post". | #3 - N. end of headwall S60°E 37.1' | #6 - N.W. Cor. headwall N45°E 51.62' |
| | #4 - Storm drain cover S70°W 44.9' | #7 - Guard Post S50°E 41.10' |
| | | #8 - S.W. Cor. headwall - East 36.39' |
| | | #9 - 3/4" Pipe N89°52'40"E 12.55' |
| | | (Corner common to Sec. 33 & 34, T19N R10W) |

B. Description of corner evidence found and/or method applied in restoring of reestablishing corner:

I found an Osceola County Monument (1" Pipe) with the brass disk broken off next to a 1" solid iron rod. Corner is in an old road grade (proposed North bound lane of Old U.S. 131). It is 71 feet East of the painted centerline of North and South blacktop road (Mackinaw Trail).


Condition of the accessories are as follows: #1 Gone, #2 Gone, #3 Found in good condition, #4 Found in good condition, #5 Found dead, #6 Found in good condition, #7 Found in good condition, #8 Found in good condition, #9 Found in good condition.

C. Description of monument for corner and accessories established to perpetuate locating the position of the corner:

I replaced the old Osceola Co. Monument with a 1" x 18" Pipe with Osceola County Remon Cap, and is accepted as a careful and faithful reestablishment of the position of the original corner.

- 12" W. Pine N07°E 98.48' (60d spike E. side)
- 8" Ash N84°W 179.21' (60d spike S. side)
- 6" W. Pine S02°W 221.45' (60d spike W. side)
- 12" W. Pine S78°E 160.77' (60d spike S. side)
- Osceola County Monument - East 12.43' (Corner of Sections 33 & 34, T19N, R10W)

APPROVED LAND CORNER
 P.A. 345 OF 1890
 Osceola County
R. L. Wetherell
 4-20-2000

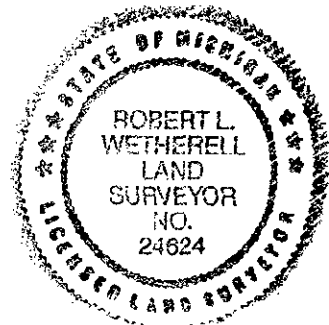

Signed by Robert L. Wetherell Date April 25, 2000
 Surveyor's Michigan License No. 24624