LAND CORNER RECORDATION CERTIFICATE

Filing Requirement of Act 74, Mich. P.A. 1970

For corners in OSCEOLA (County)

	Located In:	Corner Code ##
1. Public Land Survey	T 19N R 9W	L-8
	T ____ R ____	L-9
	T ____ R ____	M-9
	T ____ R ____	
2. Property Controlling	S 24 T ____ R ____	9
in Section	S ____ T ____ R ____	
3. Miscellaneous	S ____ T ____ R ____	
Property in Sec.	S ____ T ____ R ____	

Register of Deeds Stamp & File Number

4. Lot No. _____, Recorded Plat _____
5. Private Claims _____

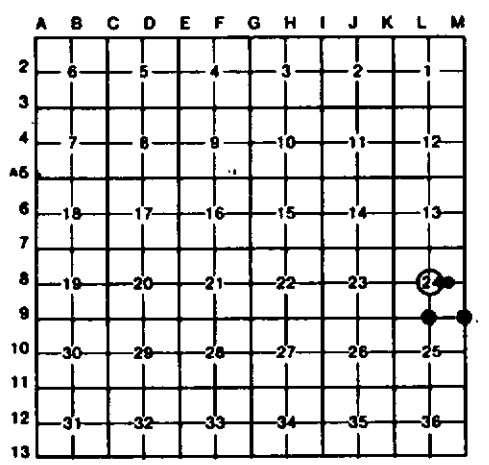

I, CARL F. ROSER, in a field survey on 04/18, 19 84, do hereby certify that under requirements of P.A. 74, Michigan P.A. of 1970, the corner points mentioned in lines 1 and 2 above were in conformance with regulations and rules therefore as required in the current manual of survey instructions of the United States Department of the Interior, Bureau of Land Management or by a decree of a Court of Law and/or that the corner points mentioned in lines 3, 4 and 5 above were in conformance with the rules of the Michigan Board of Land Surveyors or by a Decree of a Court of Law; established, re-established, monumented, re-monumented, recovered, found as expressed below:

NOTE: Not more than 4 corners, all in the same town and range, may be recorded on this certificate.

A. Description of original monument and accessories and/or subsequent restoration:

L-8 L-9 M-9 9

B. Description of corner evidence found and/or method applied in restoring or reestablishing corner:

L-8	L-9	M-9	9
FD. BRASS CAPPED P.A.S. MONUMENT AS ESTAB BY G.A.SHADKO AT INTERSECTION OF ONE-QTR LINES IN 1953. COR. FALLS IN REMAINS OF E-W FENCE.	FD. SHADKO 1953 BRASS CAPPED P.A.S. MONUMENT. SHADKO FD.. TEMPLE (1892) TILE FROM TWO FRANK MCCLUNG 1918 WITS.AT OLD COR. FN. POST. (COR POST NOW DOWN FN REMAINS N & W). CTR. OF CROOKED TRAIL (ENE & SSW) IS EAST 4'±.	FD. OLD 1/2" ROD IN 3" TILE AS SET BY CO SURVEYOR A.O.TEMPLE IN 1892. TEMPLE HAD TWO U.S.D.T.'S HERE.	FD. SHADKO BRASS CAPPED (1953) P.A.S. MONUMET FOR SE COR. OF FRL. N 1/2 OF FRL. NE 1/4 OF SEC. 24.

C. Description of monument for corner and accessories established to perpetuate locating the position of the corner:

L-8

FD PAS MON;ADDED CED POST W/LOC. TAG.

6" ASH	N45°E	12.6'
15" SUG.MAPLE	S30°W	21.5'
30" SUG.MAPLE	DUE N	24.7'
CTR.N-S TRAIL	DUE E	29'

L-9

FD PAS MON & PIECES OF TILE; ADDED CED POST W/LOC. TAG.

12" SUG.MAPLE	N50°W	29.3'
12" ASH	N25°W	16.0'
9" SUG.MAPLE	N65°E	30.8'
TOP CTR 4 1/2'X6'X4' ROCK	N80°W	47'

M-9

FD 1/2" IR ROD IN TILE;ADDED CED. POST W/LOC. TAG.

10" B.CHERRY	N60°W	53.6'
3" MAPLE	N40°E	10.4'
4" MAPLE	S75°E	11.5'
5" APPLE	S65°W	22.7'

9

FD PAS MON; ADDED CED. POST W/LOC. TAG.

9" SUG.MAPLE	N30°W	14.9'
6" SUG.MAPLE	S85°E	23.0'
5" ASH	S80°W	16.9'
OLD E-W FN REMAINS	DUE N	30'±3'

Signed by Carl F. Roser 02-05-91 Date _____

Surveyor's Michigan License No. 12020

STATE OF MICHIGAN CARL F. ROSER LAND SURVEYOR No. 12020 REGISTERED LAND SURVEYOR

FORM APPROVED BY THE MICHIGAN ASSOCIATION OF LAND SURVEYORS, JAN. 28, 1971
REVISED MAY 14, 1975
REVISED JAN., 1983