LAND CORNER RECORDATION CERTIFICATE

Filing Requirement of Act 74, Mich. P.A. 1970

For corners in
OSCEOLA
(County)

	Located In:	Corner Code ##
1. Public Land Survey	T 19N R 9W	L-7
	T ____ R ____	N-8
	T ____ R ____	
	T ____ R ____	
2. Property Controlling	S ____ T ____ R ____	
in Section	S ____ T ____ R ____	
3. Miscellaneous	S 24 T ____ R ____	*1883'N OF
Property in Sec.	S ____ T ____ R ____	S-24 CODE?

Register of Deeds Stamp & File Number

4. Lot No. _____ , Recorded Plat _____
5. Private Claims _____

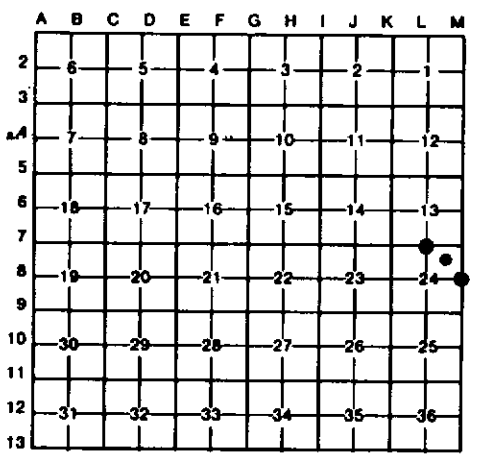

I, CARL F. ROSER, in a field survey on 04/18, 19 84, do hereby certify that under requirements of P.A. 74, Michigan P.A. of 1970, the corner points mentioned in lines 1 and 2 above were in conformance with regulations and rules therefore as required in the current manual of survey instructions of the United States Department of the Interior, Bureau of Land Management or by a decree of a Court of Law and/or that the corner points mentioned in lines 3, 4 and 5 above were in conformance with the rules of the Michigan Board of Land Surveyors or by a Decree of a Court of Law; established, re-established, monumented, re-monumented, recovered, found as expressed below:

NOTE: Not more than 4 corners, all in the same town and range, may be recorded on this certificate.

A. Description of original monument and accessories and/or subsequent restoration:

L-7
N-8
*

B. Description of corner evidence found and/or method applied in restoring or reestablishing corner:

L-7
FD.SHADKO'S (1953) CAP BROKE OFF P.A.S. MONUMENT. FITS 1892 NIT. BY CO. SURVEYOR A.O.TEMPLE WHO HAD U.S.B.T.HERE. COR IN CTR OF E-W DIRT RD.

N-8
FD. SHADKO (1953) BRASS CAPPED P.A.S. MONUMENT W/1/2" ROD & 3" TILE ALONG SIDE IN 8" OF WATER IN WESTERLY SIDE OF MARSH. SHADKO HAD 1892 CO.SURVEYOR A.O.TEMPLE'S ROD & TILE; TEMPLE HAD BOTH U.S.B.T.'S. TEMPLES N.B.T.,40"PINE STP, S79°W,45 LINKS IS STILL EVIDENT.

*
FD SHADKO BRASS CAPPED (1953) P.A.S. MONUMENT AT INTERSECTION OF E LINE OF FRL. W 1/2 OF FRL. NE 1/4 OF SEC. 24 WITH SHORE OF SUNRISE LK; N02° 59'56"W, 1883.14' FROM E 1/8 COR ON E-W 1/4 LINE OF SEC.24.

C. Description of monument for corner and accessories established to perpetuate locating the position of the corner:

L-7
FD PAS MON & 3"X12" TILE.

P. POLE	N10°E	35.47'
HIGH PT ON 4'X6'ROCK	N45E	103'
10" R.OAK	N30°E	83.53'
SET CED POST W/LOC.TAG.	DUE S	33'

N-8
FD PAS MON BESIDE 3" TILE W/1/2" IR ROD,ADDED CED POST.

4" MAPLE	S85°W	40.2'
6" MAPLE	N50°W	45.6'
10" MAPLE	N15°W	43.9'
W'LY EDGE MARSH	DUE W	26.25'

*
FD PAS MON; ADDED CED POST.

8" W.BIRCH	N35 W	15.82'
28" MAPLE	N70 E	18.47'
18" MAPLE	S60 W	15.00'
SLY EDGE SUNRISE LK.	DUE N	55'

STATE OF MICHIGAN
CARL F. ROSER
LAND SURVEYOR
No. 12028
REGISTERED LAND SURVEYOR

Signed by Carl F. Roser 02-05-91 Date _____

Surveyor's Michigan License No. 12028

FORM APPROVED BY MICHIGAN STATE BOARD OF LAND SURVEYORS, JAN. 28, 1971
REVISED MAY 14, 1975
REVISED JAN., 1983